


T.2S.R.2W.W.M.

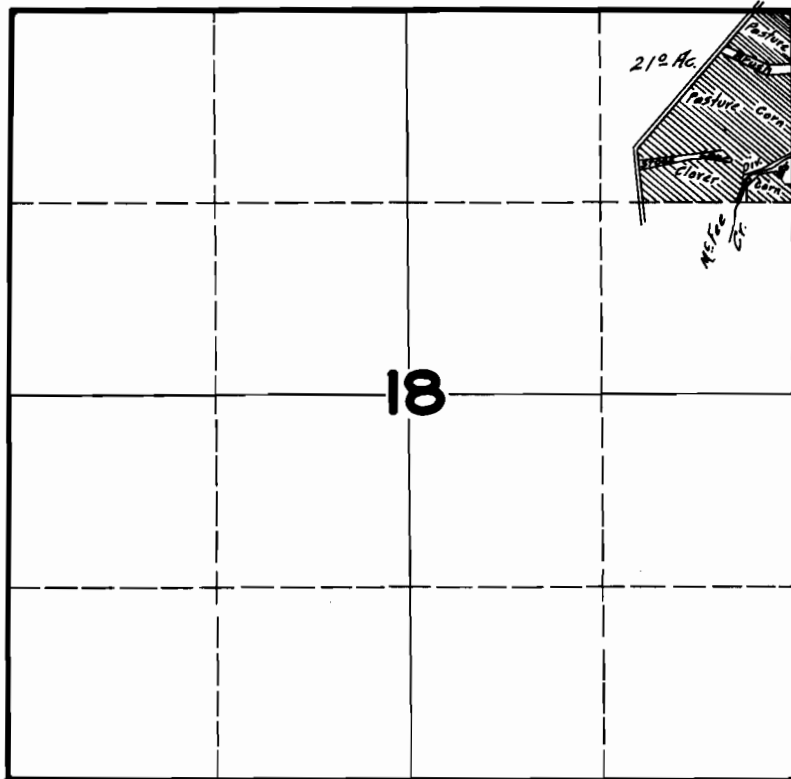

**FINAL PROOF SURVEY**  
UNDER

Application No. 19095 Permit No. 14685

IN NAME OF

EGGER BROS. - EMIL & FRITZ

Surveyed JUNE 14 1945, by [Signature]