


T. 7S. R. 5 & 6 W.W.M.

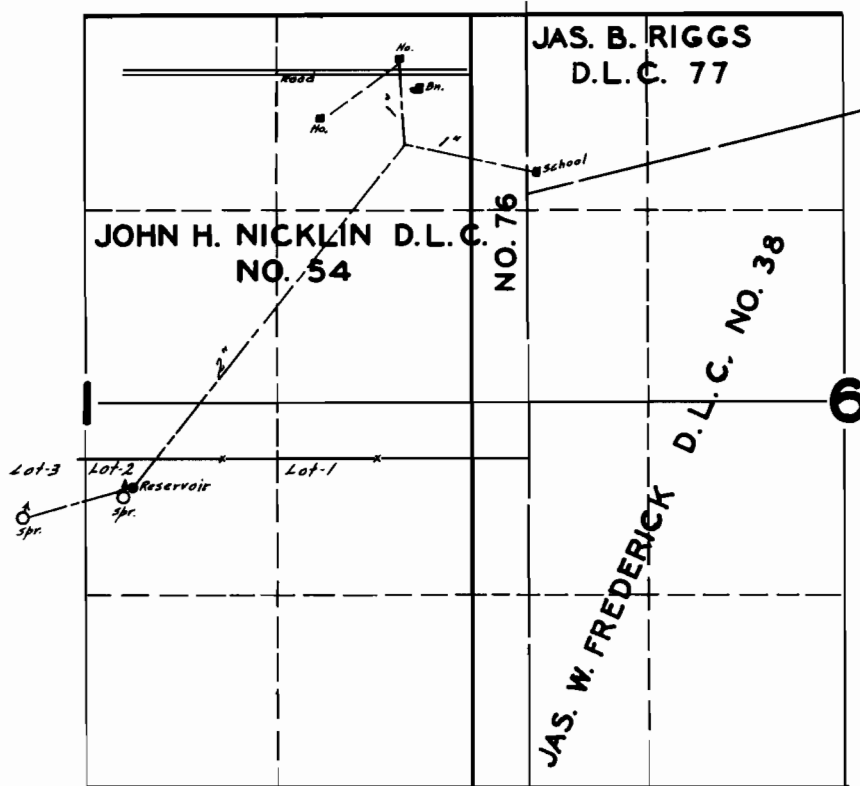

FINAL PROOF SURVEY

UNDER

Application No. 19022 Permit No. 14701

IN NAME OF

BERT CLANFIELD

Surveyed JUNE 8, 1945, by