


T.5S.R.7W.W.M.

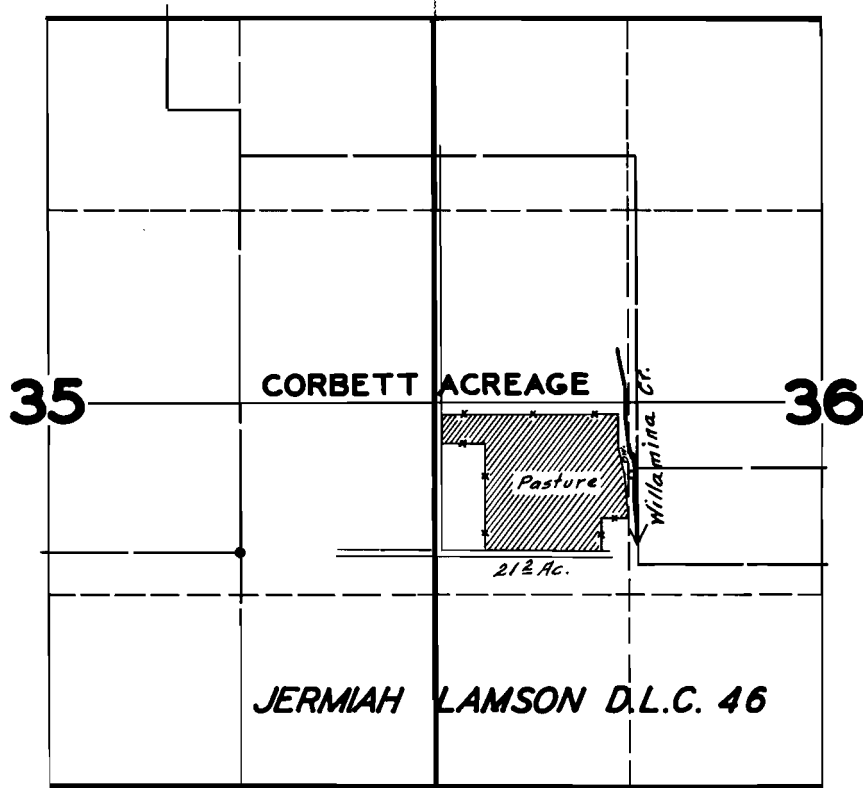

FINAL PROOF SURVEY
UNDER

Application No. 19177 Permit No. 14774

IN NAME OF

WILLIAM L. FOWLER

Surveyed JUNE 8 1945