


T.2S. R. 2E.W.M.

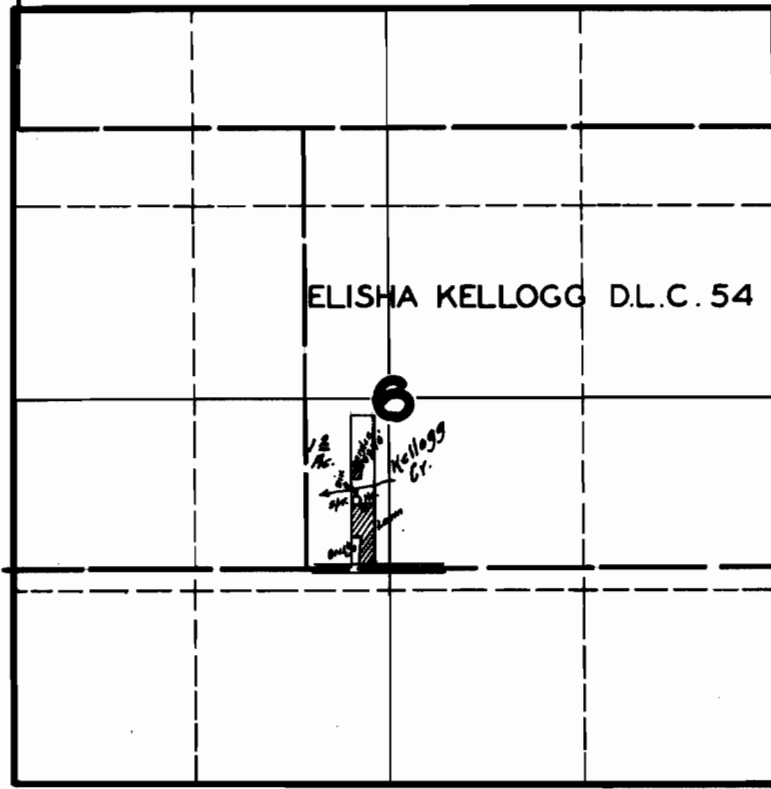

FINAL PROOF SURVEY
UNDER

Application No. 19191 Permit No. 14788

IN NAME OF
S.R. SMITH.

Surveyed JULY 3, 1945, by *J. Russell*