


T.4S. R.3W.W.M.

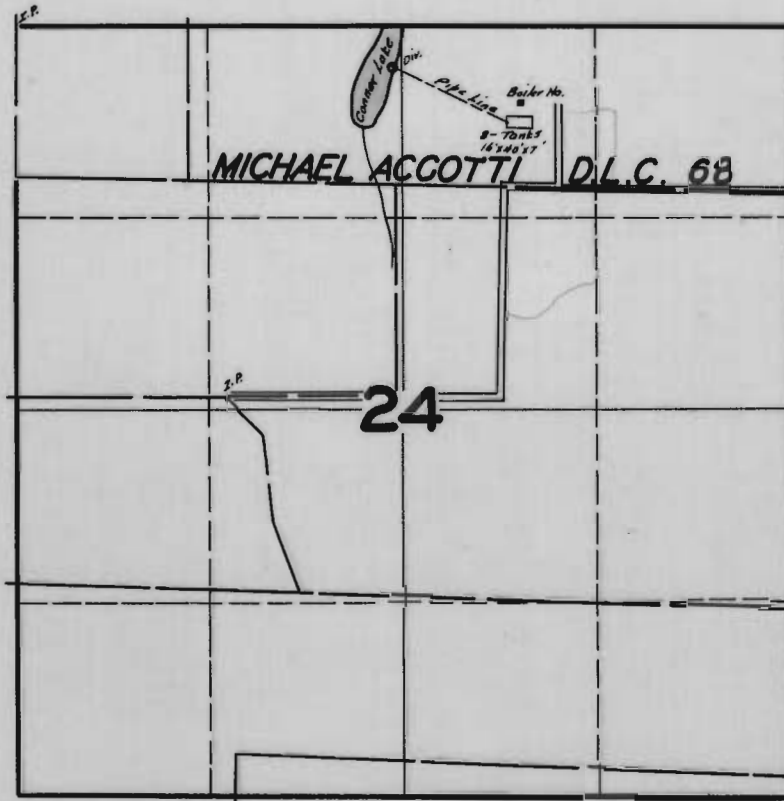

**FINAL PROOF SURVEY**  
UNDER

Application No. 19222 Permit No. 14812

IN NAME OF

ST. PAUL FLAX GROWERS CO-OPERATIVE.

Surveyed MAY 4 1945