


T.10S. R.4W.W.M.

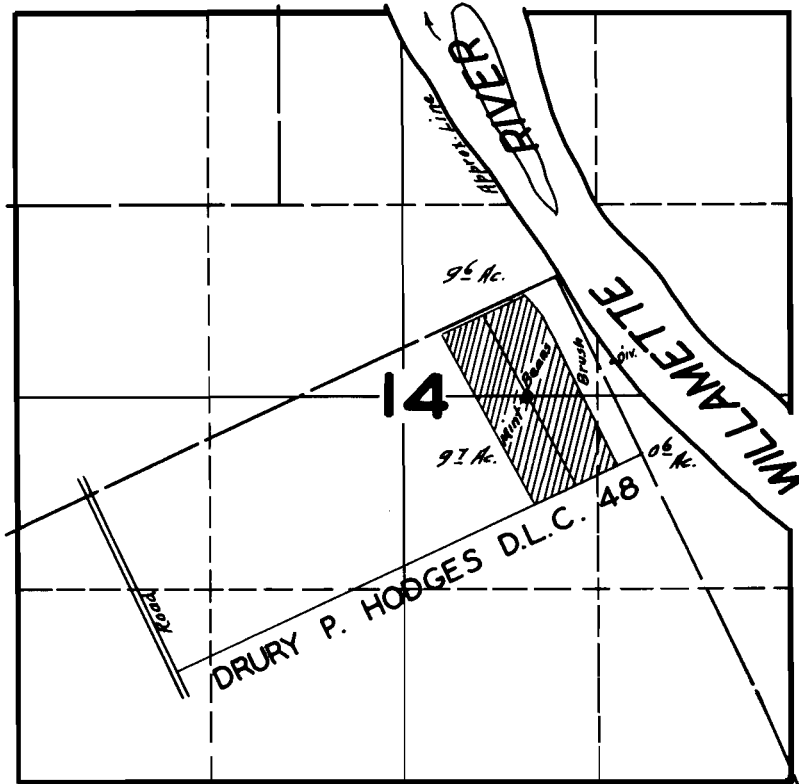

FINAL PROOF SURVEY
UNDER

Application No. 19240 Permit No. 14824

IN NAME OF

FRANK SADLER

Surveyed JULY 6, 1945, by