


T.17S.R.6W.W.M.

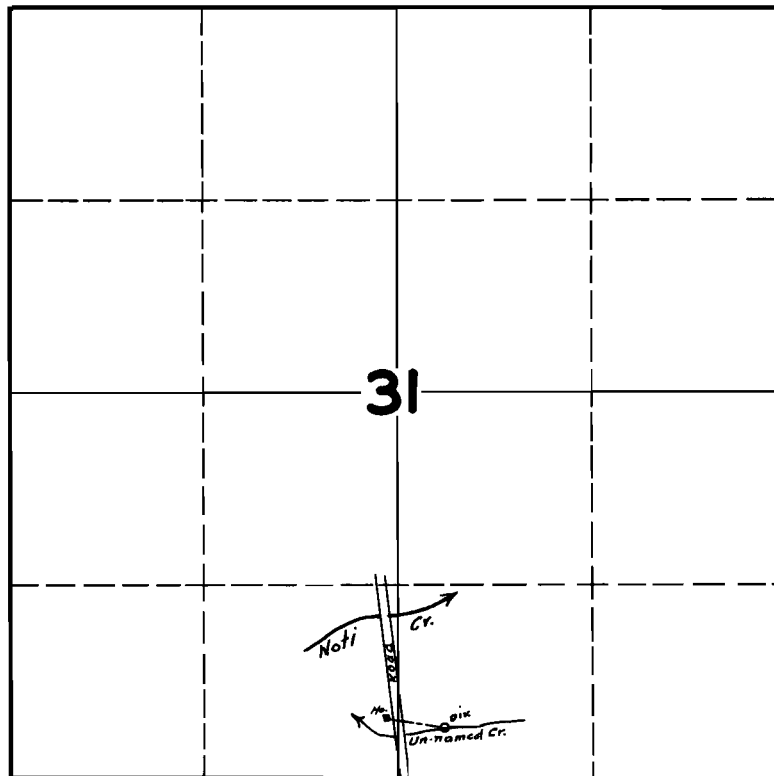

FINAL PROOF SURVEY
UNDER

Application No. 19263 Permit No. 14862

IN NAME OF

ARTHUR CRESON

Surveyed AUG. 3, 1945, by [Signature]