


T.38S. R.14W.W.M.

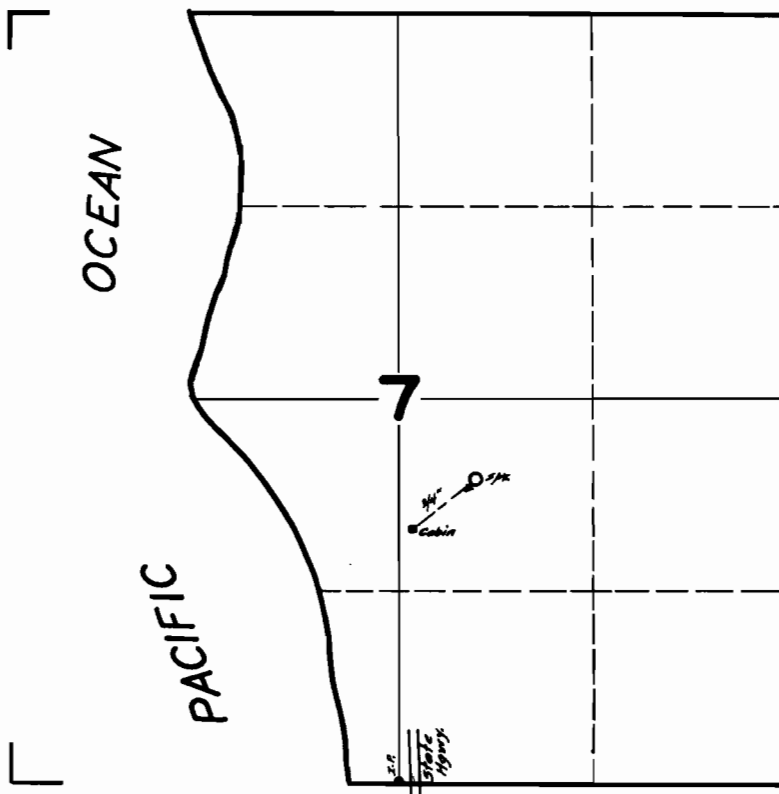

**FINAL PROOF SURVEY
UNDER**

Application No. 19276 Permit No. 14870

IN NAME OF

WILLIAM H. & FRANCES S. HENRY

Surveyed JULY 16, 1945, by [Signature]