


T.4S. R.2 & 3W.W.M.

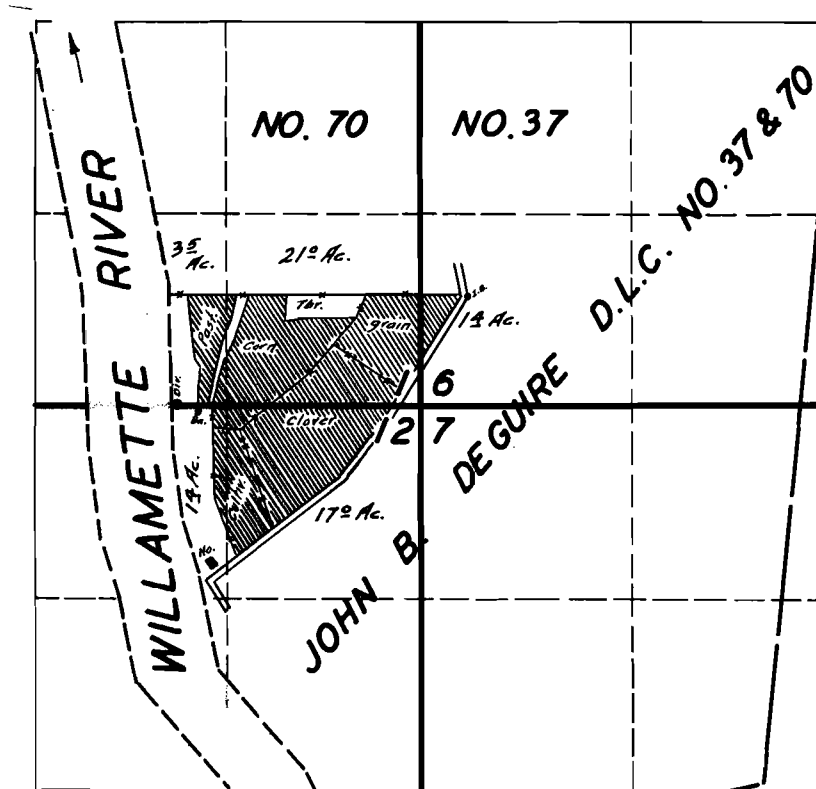

FINAL PROOF SURVEY

UNDER

Application No. 19283 Permit No. 14875

IN NAME OF

JERRY MC. CARTHY

Surveyed MAR. 9 1946, by [Signature]