


T.17S. R.3W.W.M.

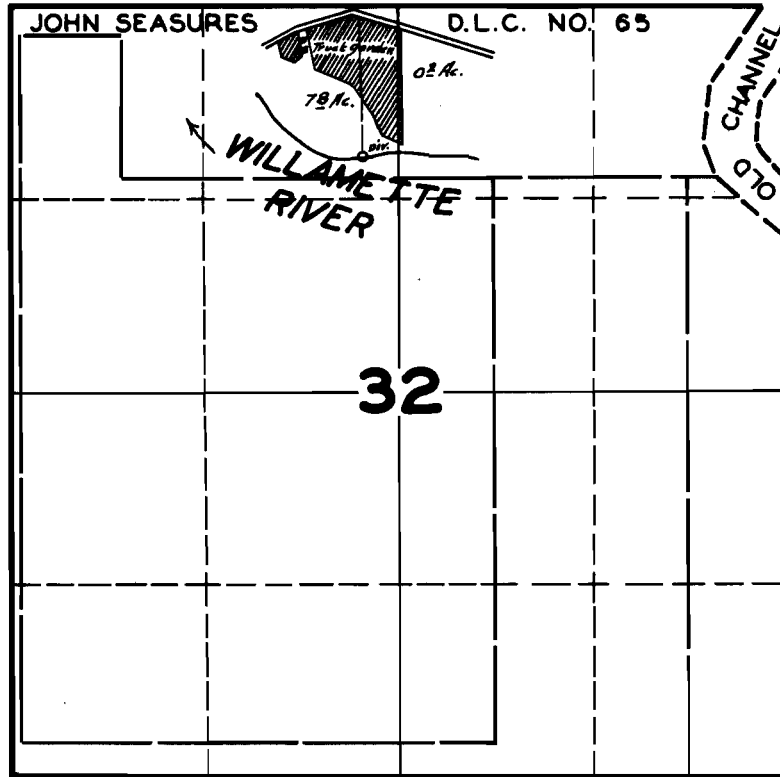

**FINAL PROOF SURVEY**  
UNDER

Application No. 19295 Permit No. 14883

IN NAME OF

VINCENZO BAVARO

Surveyed AUG. 3, 1945, by [Signature]