


T. 5 S. R. 1 W. W. M.

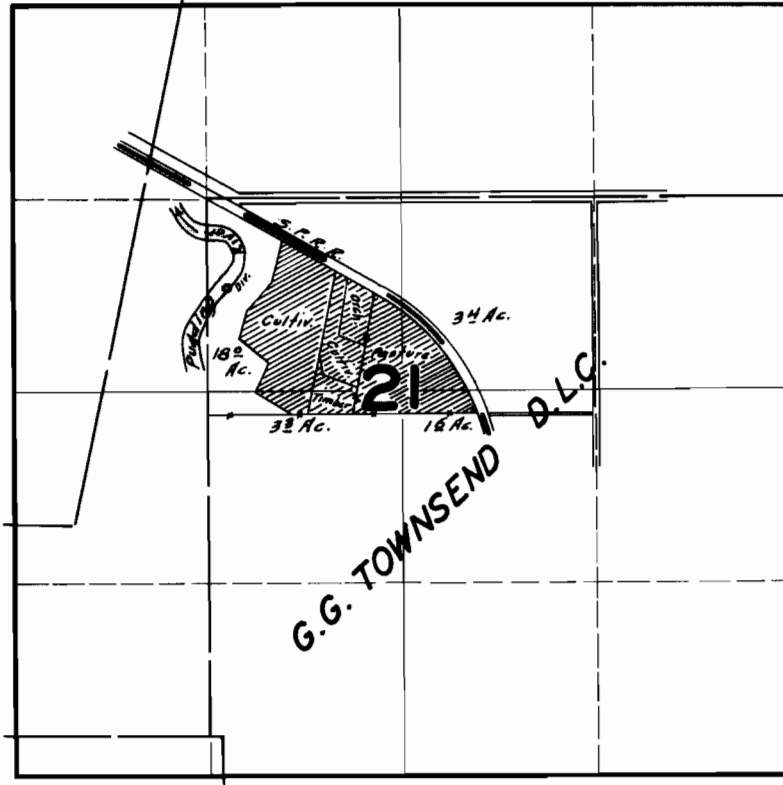

FINAL PROOF SURVEY

UNDER

Application No. 19316 Permit No. 14899

IN NAME OF

JOHN SEETHOFF

Surveyed MAY 23, 1945, by

[Signature]