


T.6S. R.3E.W.M.

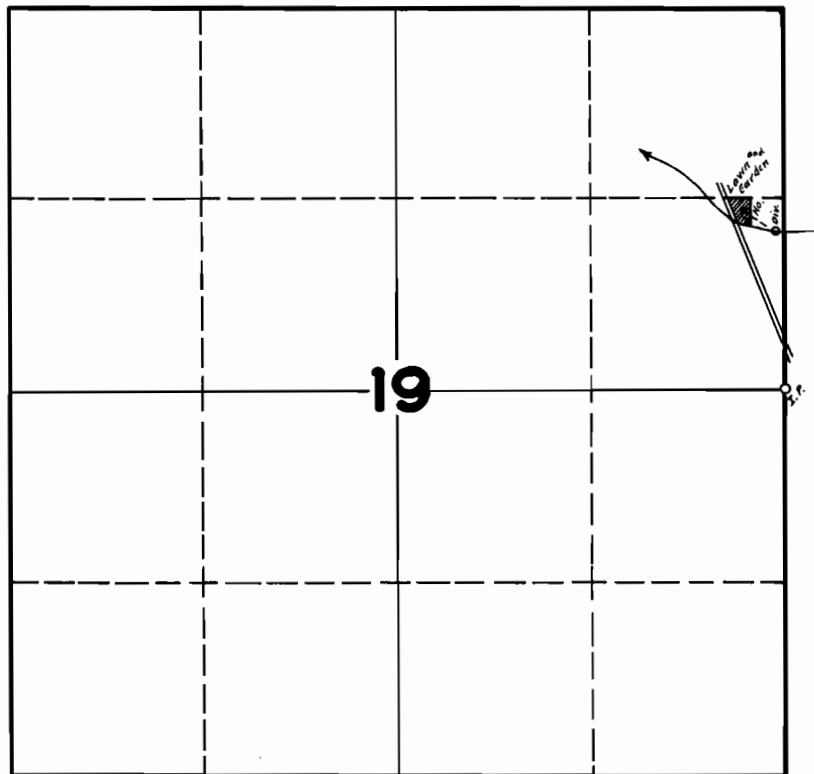

FINAL PROOF SURVEY
UNDER

Application No. 19271 Permit No. 14915

IN NAME OF

GERALD JENSEN & HELEN JENSEN

Surveyed MAR. 29 1946, by *[Signature]*