


T.4 & 5S. R.I.E. W.M.

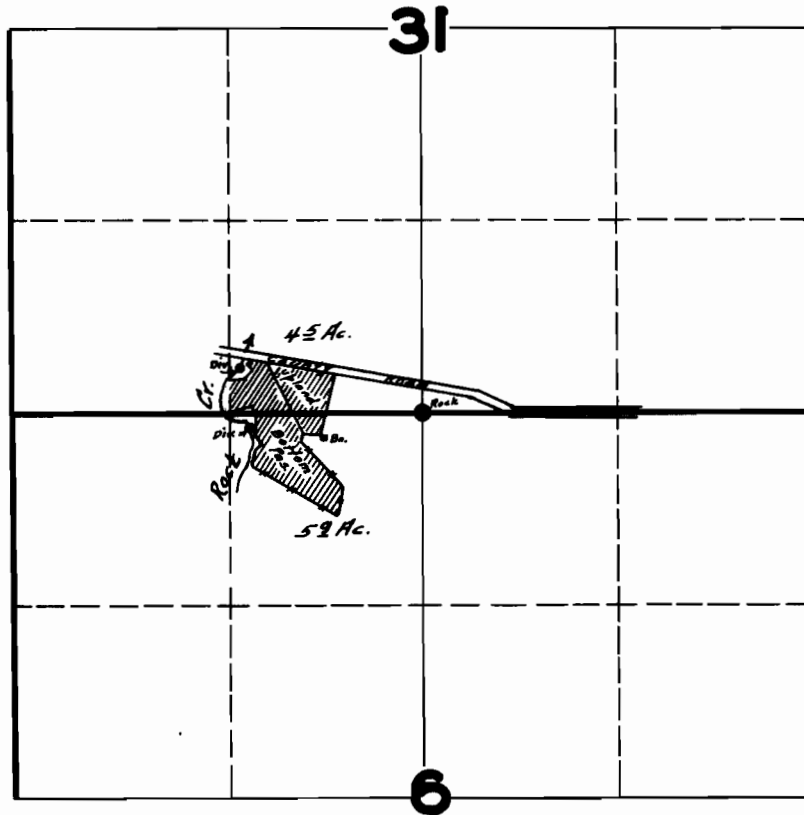

FINAL PROOF SURVEY UNDER

Application No. 19337 Permit No. 14927

IN NAME OF

P. A. WEBER

Surveyed MAY 3, 1945, by

James H. Russell