


T. 9S. R. 2W. W.M.

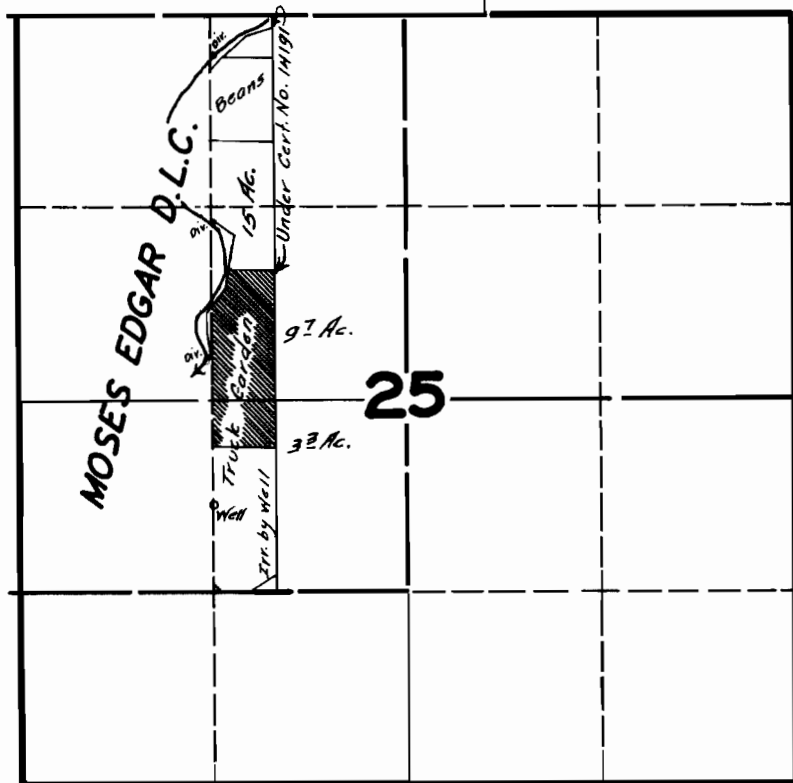

**FINAL PROOF SURVEY**

**UNDER**

Application No. 19340 Permit No. 14929

IN NAME OF

WILLIAM TOWERY

Surveyed MAR. 19, 1946 by [Signature]