


T.19S. R.1W.W.M.

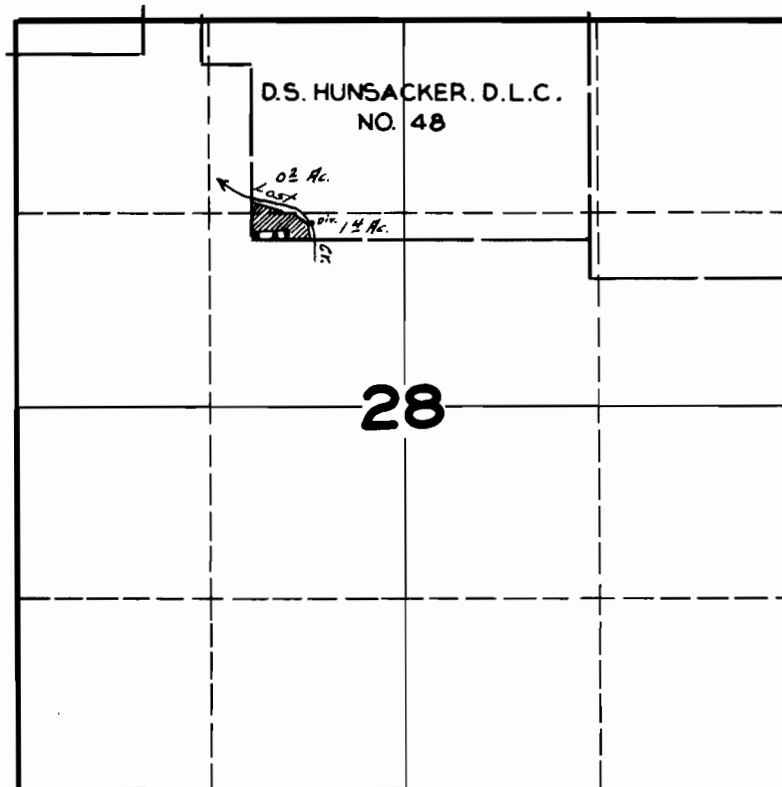

FINAL PROOF SURVEY
UNDER

Application No. 19349 Permit No. 14936

IN NAME OF

HENRY Z. GIBBEL

Surveyed JULY 31, 1945, by *[Signature]*