


T. 5S. R. 8W. W.M.

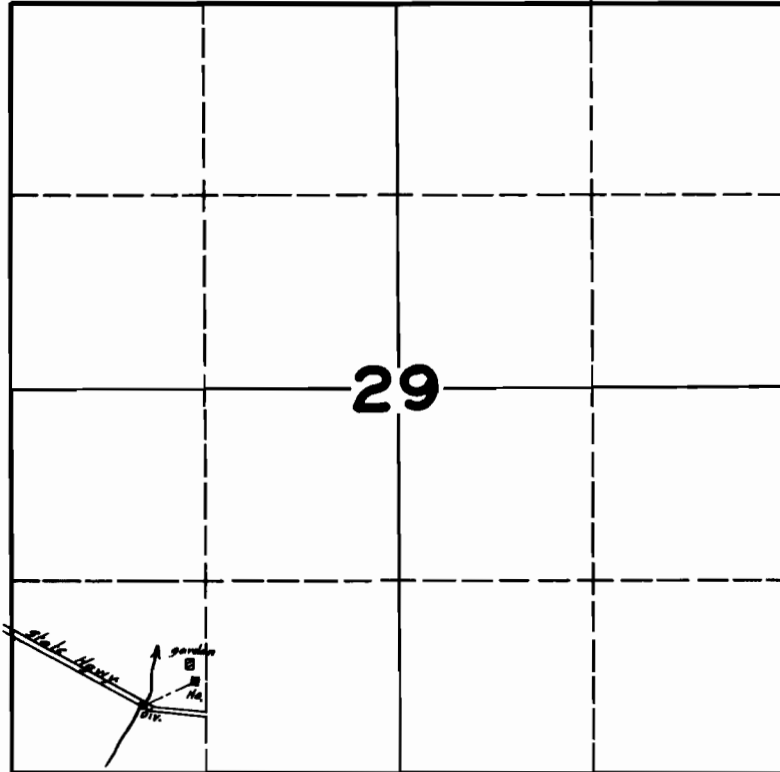

FINAL PROOF SURVEY
UNDER

Application No. 19358 Permit No. 14942

IN NAME OF

ISADOR ERICKSON

Surveyed JUNE 6, 1945 *[Signature]*