


# T.11S. R.4W.W.M.

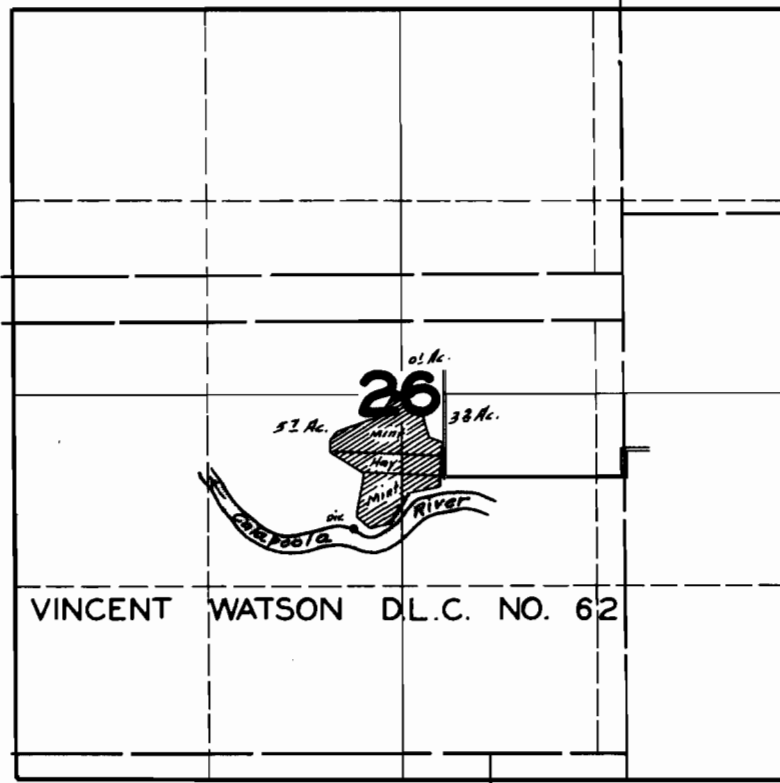

## FINAL PROOF SURVEY UNDER

Application No. 19367 Permit No. 14949

IN NAME OF

H. MC. NAUGHTAN

Surveyed JUNE 25 1945 by *James J. Ginnell*