


T.4S. R. 7W.W.M.

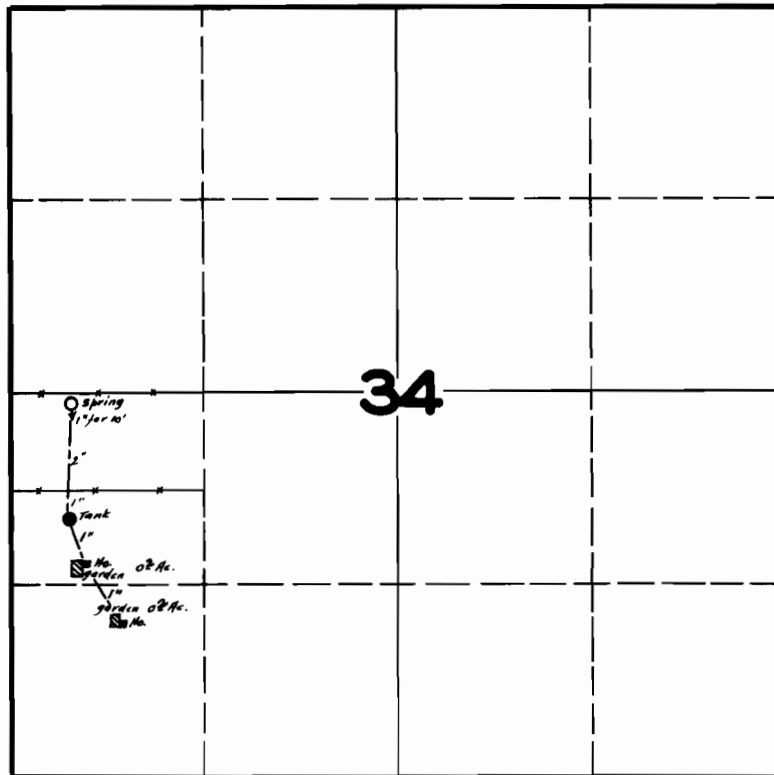

**FINAL PROOF SURVEY
UNDER**

Application No. 19375 Permit No. 14953

IN NAME OF

R. L. BROWN.

Surveyed MAR. 4 1946. by [Signature]