


T.17S.R.12W.W.M.

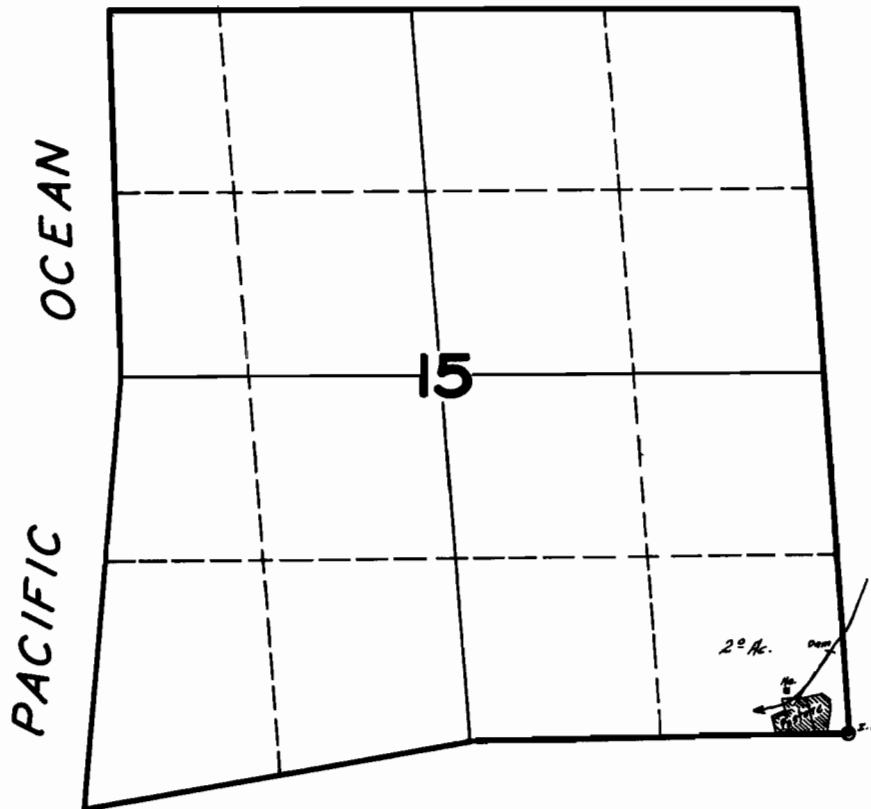

**FINAL PROOF SURVEY
UNDER**

Application No. 19376 Permit No. 14954

IN NAME OF

A.G. & EVA A. HINES

Surveyed AUG. 7, 1945, by [Signature]