


# T.2S. R.3E.W.M.

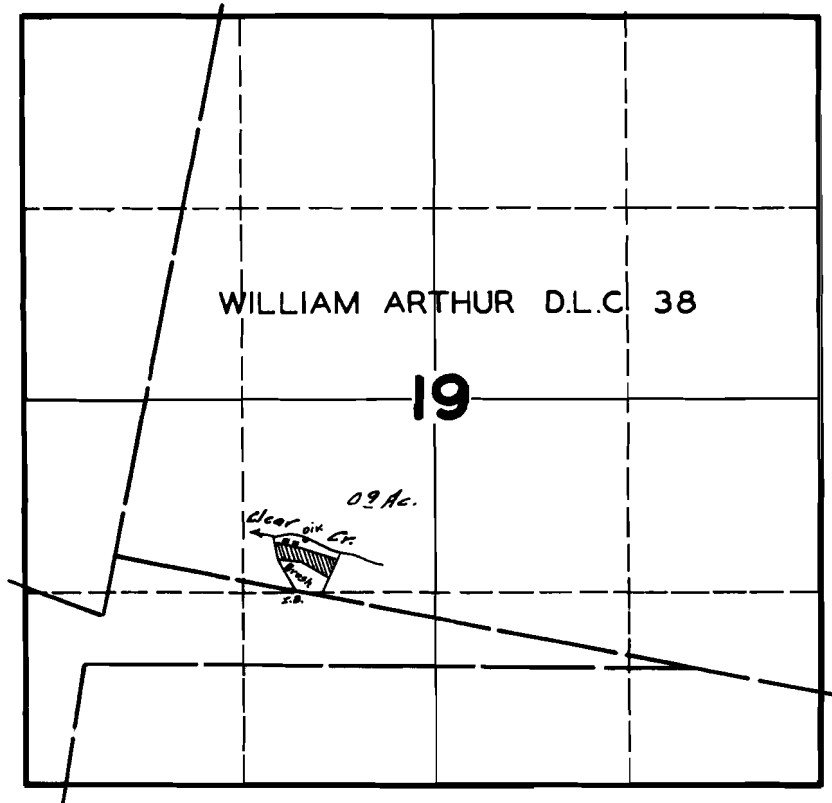

## FINAL PROOF SURVEY UNDER

Application No. 19398 Permit No. 14981

IN NAME OF

PAUL A. GIERKE.

Surveyed JUNE 15 1945 by [Signature]