


T.3S. R. 1W.W.M.

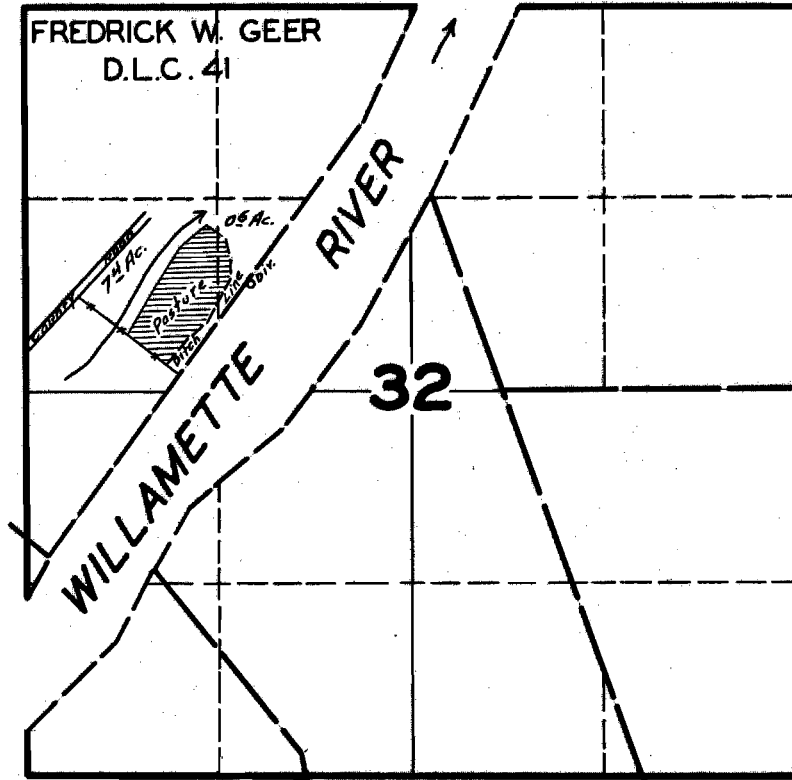

FINAL PROOF SURVEY UNDER

Application No. 19436 Permit No. 15035

IN NAME OF

MARTHA L. STRUVE

Surveyed MAY 5, 1945, by [Signature]