


T.24S.R.13W.W.M.

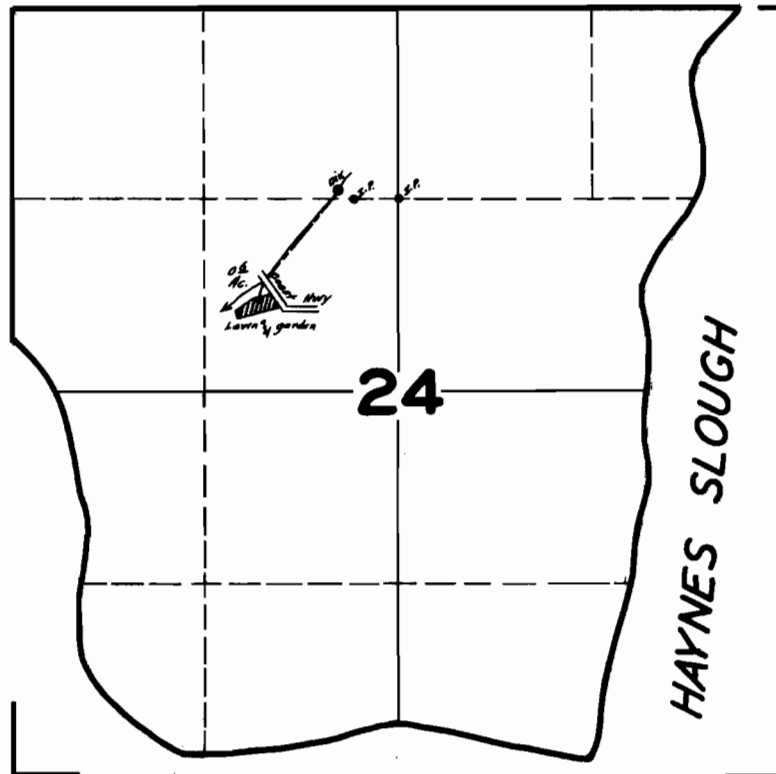

**FINAL PROOF SURVEY
UNDER**

Application No. 19450 Permit No. 15044

IN NAME OF

BUFORD KIGHT

Surveyed JULY 20 1945 by [Signature]