


T.35S.R.14W.W.M.

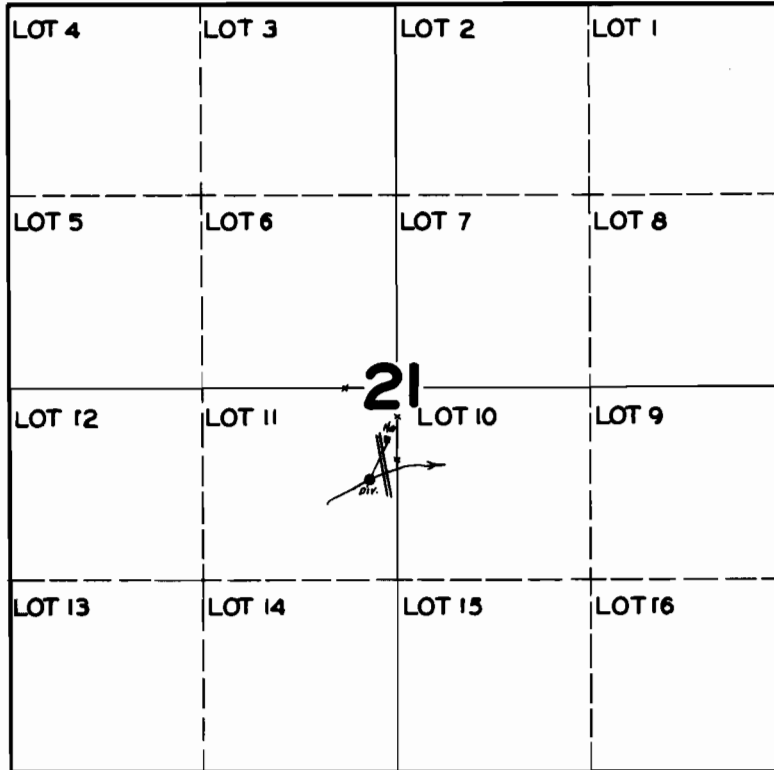

FINAL PROOF SURVEY UNDER

Application No. 19462 Permit No. 15051

IN NAME OF

R. F. LECLAIR

Surveyed JULY 17, 1945 by James S. Russell