


T.3S.R.2W.W.M.

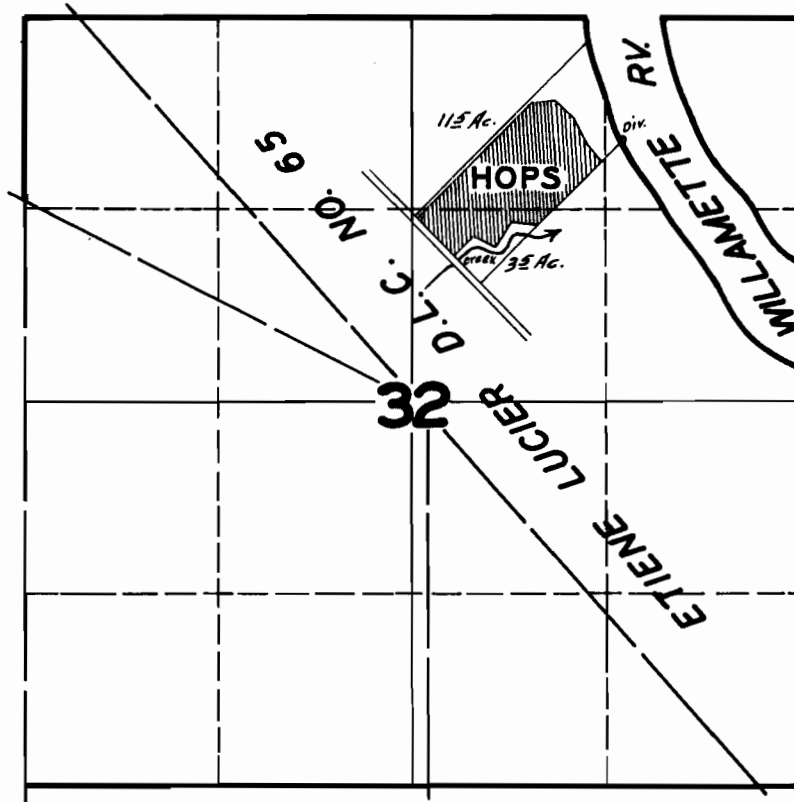

FINAL PROOF SURVEY
UNDER

Application No. 19472 Permit No. 15055

IN NAME OF

WALTER J. GEARIN

Surveyed AUG. 13, 1945, by