


T.17S.R.10W.W.M.

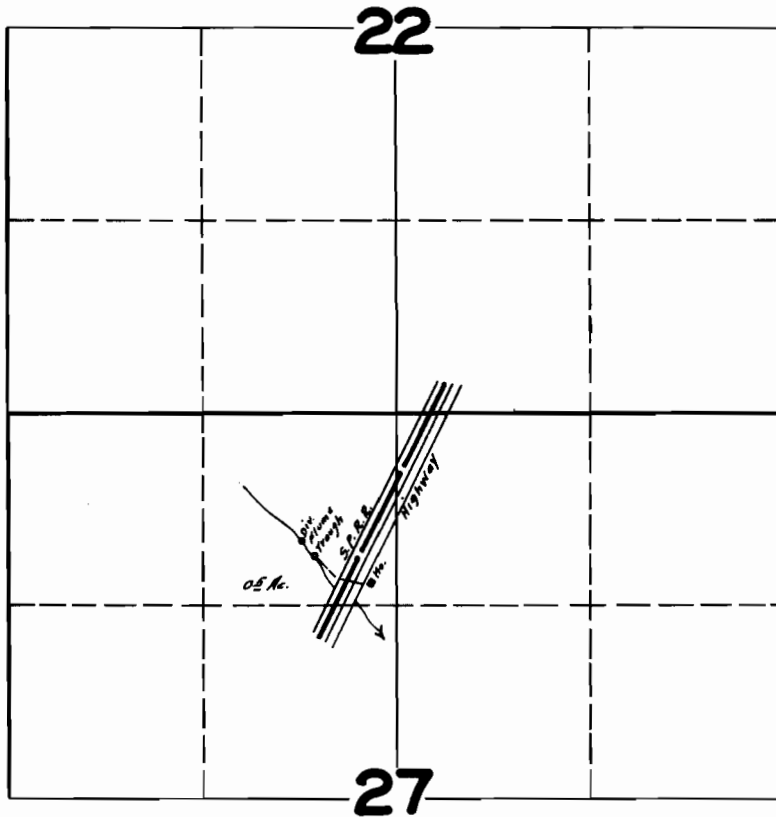

FINAL PROOF SURVEY
UNDER

Application No. 19474 Permit No. 15057

IN NAME OF
ROSCOE E. BRYANT

Surveyed AUG. 7, 1945, by [Signature]