


# T. 1 S. R. 3 W. W. M.

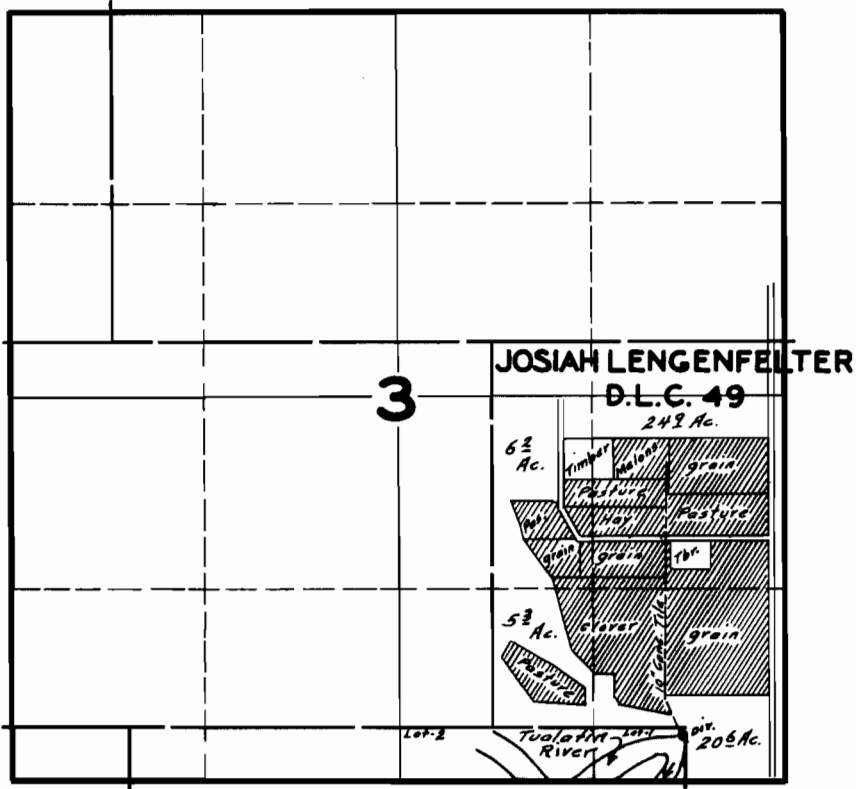

## FINAL PROOF SURVEY UNDER

Application No. 19475 Permit No. 15058

IN NAME OF

C. B. BUCHANAN

Surveyed AUG. 27 1945 by [Signature]