


T. 9 S. R. 7 E. W. M.

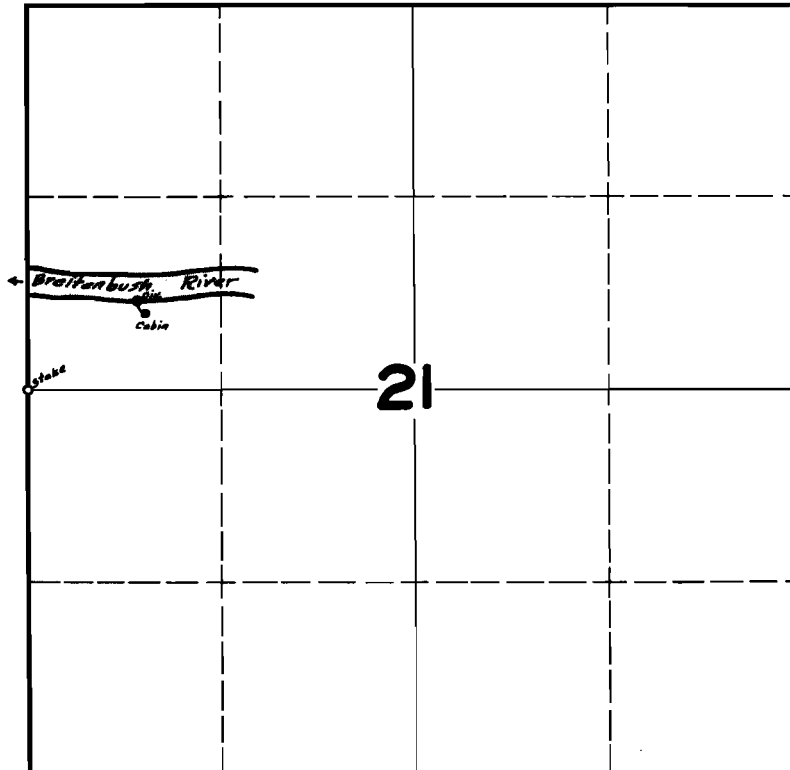

**FINAL PROOF SURVEY
UNDER**

Application No. 19446 Permit No. 15089

IN NAME OF
REVEREND ROBERT S. NEUGEBAUER

Surveyed JULY 25 1945 by W. C. Russell