


T.2S.R.2W.W.M.

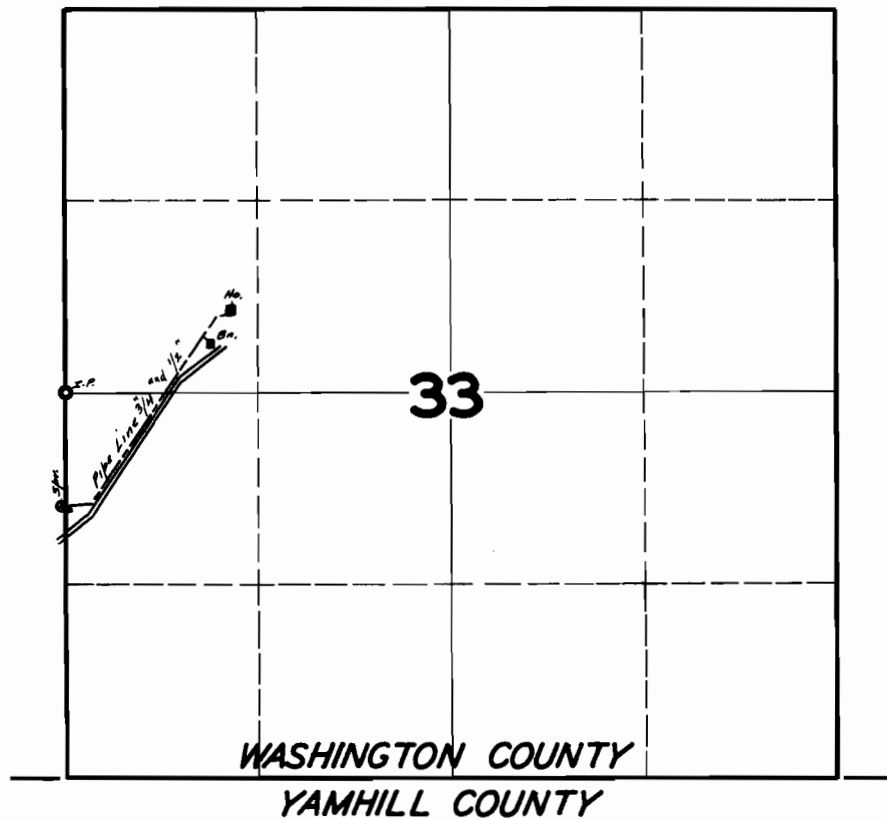

**FINAL PROOF SURVEY
UNDER**

Application No. 19532 Permit No. 15122

IN NAME OF

HENRY V. BUTCHER & VERDA M. BUTCHER

Surveyed JUNE 14 1945, by James H. Sumrell