


T.7S.R.3W.W.M.

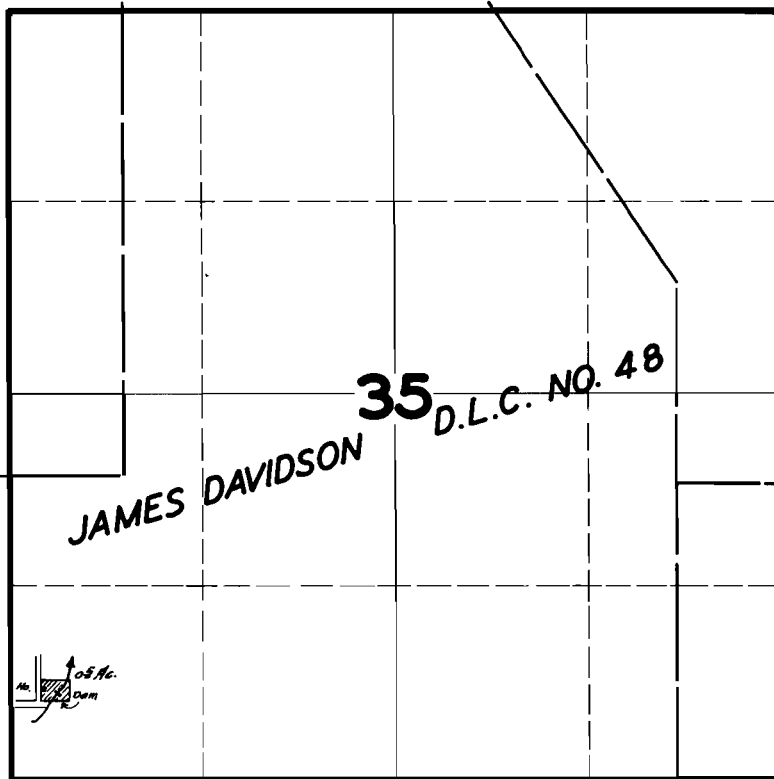

FINAL PROOF SURVEY

UNDER

Application No. 19628 Permit No. 15203

IN NAME OF

EARL H. & LILLIAN A. WASHBURN

Surveyed MAY 15, 1945, by *James P. Sumrell*