


T.2N.R.4W.W.M.

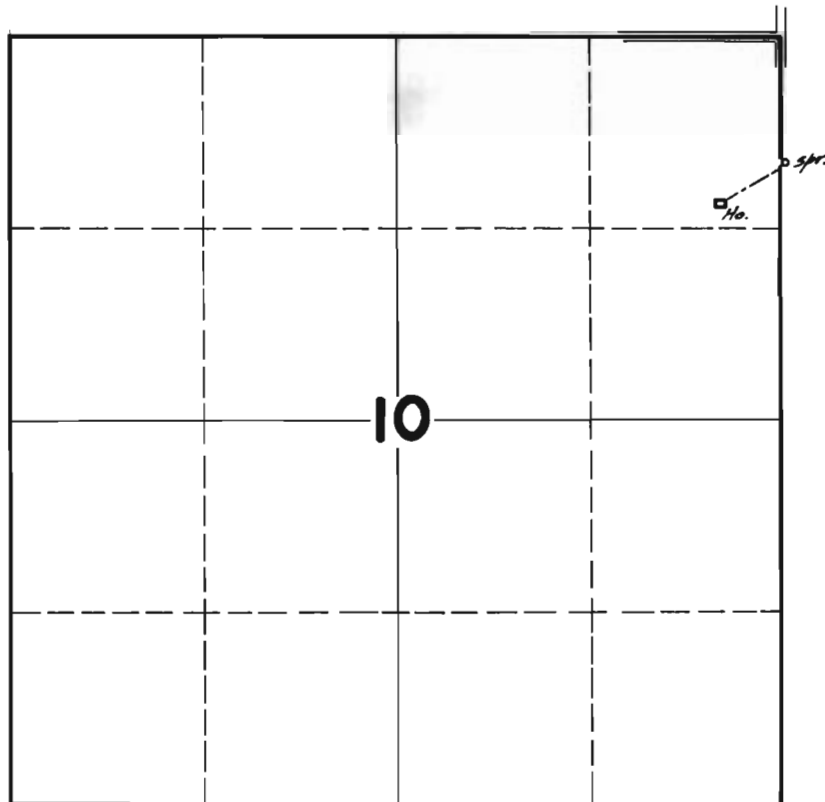

**FINAL PROOF SURVEY
UNDER**

Application No. 19693 Permit No. 15272

**IN NAME OF
JACK & EVA A. CONGROVE**

Surveyed JUL. 31. 1944. by JAS. E. BUNNELL