


T.13S.R.1E.W.M.

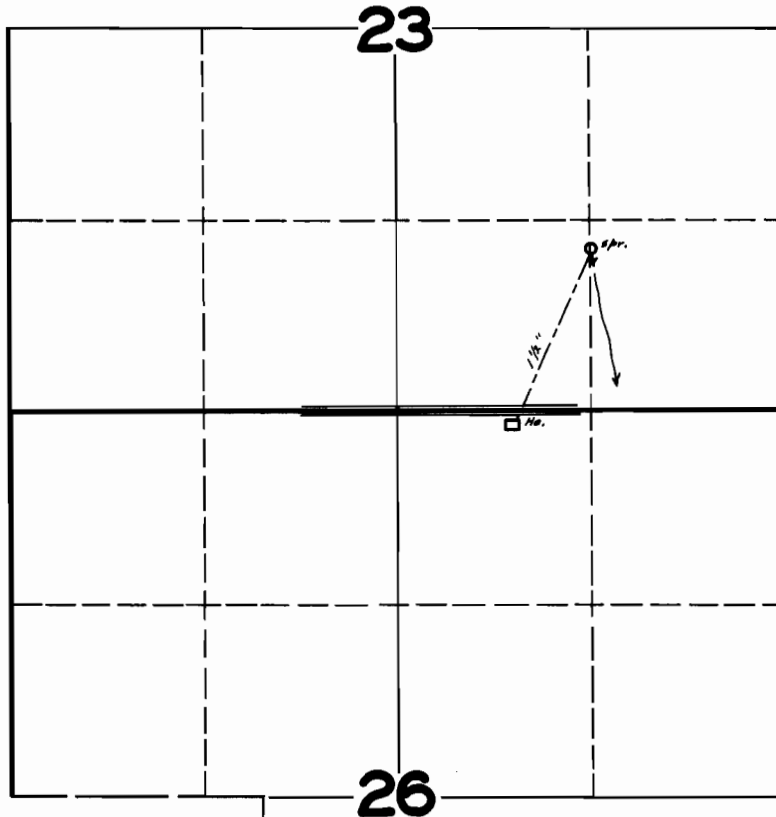

FINAL PROOF SURVEY
UNDER

Application No. 19613 Permit No. 15419

IN NAME OF

J. P. HARRANG

Surveyed JUNE 26 1945 *[Signature]*