


# T. 16 S. R. 4 W. W. M.

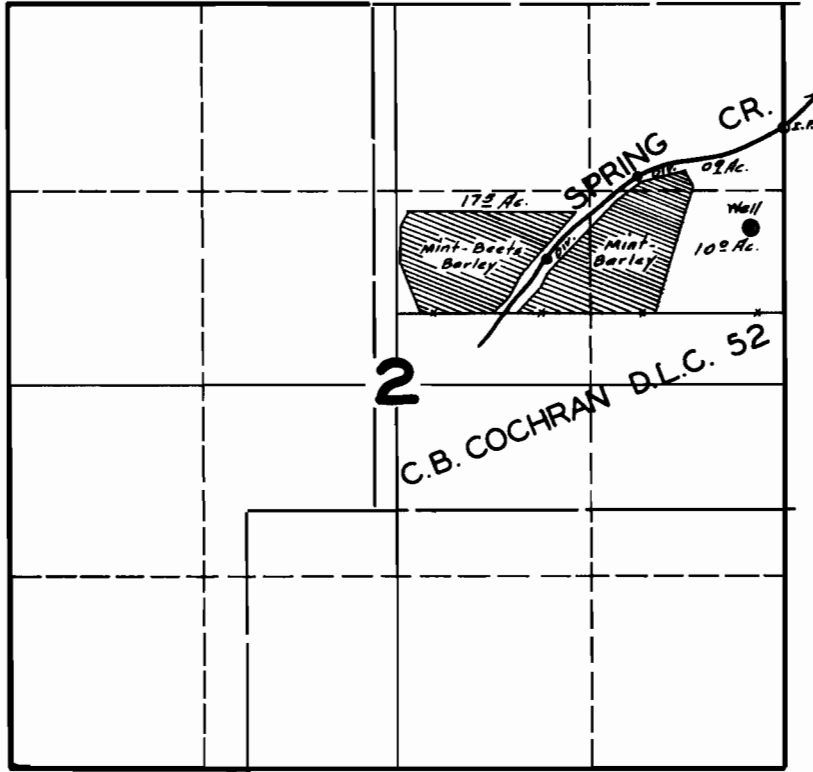

## FINAL PROOF SURVEY UNDER

Application No. 19845 Permit No. 15426

IN NAME OF

V. H. WOODS

Surveyed JUNE 26 1945 by W. H. Rummell