


T.18S.R.10W.W.M.

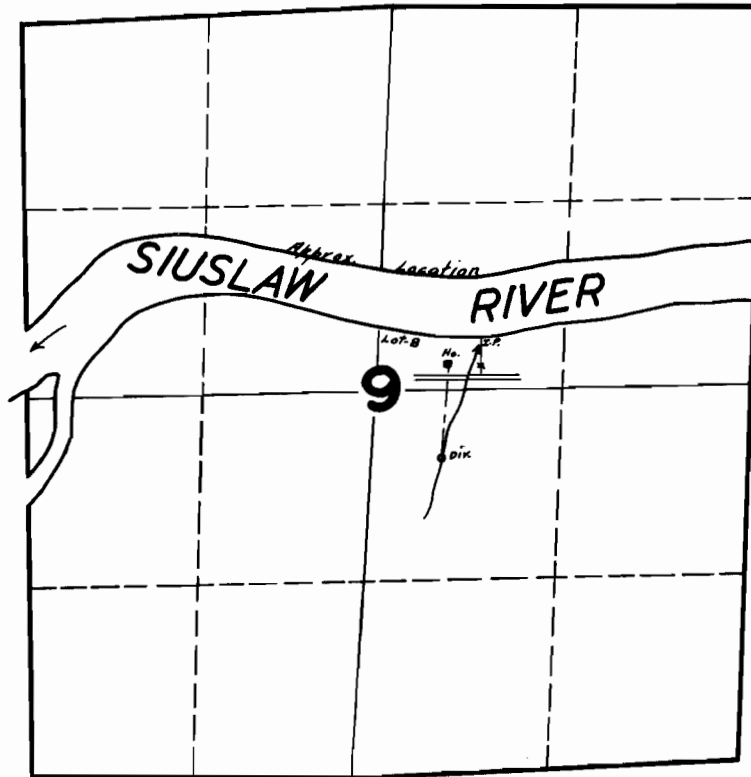

FINAL PROOF SURVEY
UNDER

Application No. 19849 Permit No. 15471

IN NAME OF

HAROLD POOLE

Surveyed AUG. 7, 1945, by