


T.3S.R.2W.W.M.

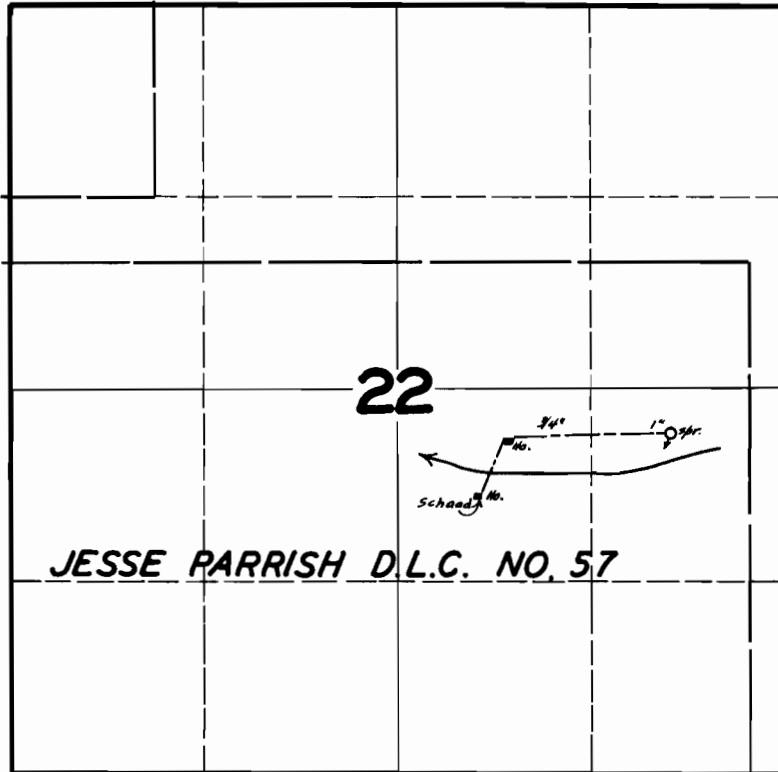

**FINAL PROOF SURVEY**  
UNDER

Application No. 19880 Permit No. 15472

IN NAME OF

WESLEY A. SCHAAD

Surveyed JUNE 16, 1945, by *W. A. Schaad*