


T.2S. R.2E.W.M.

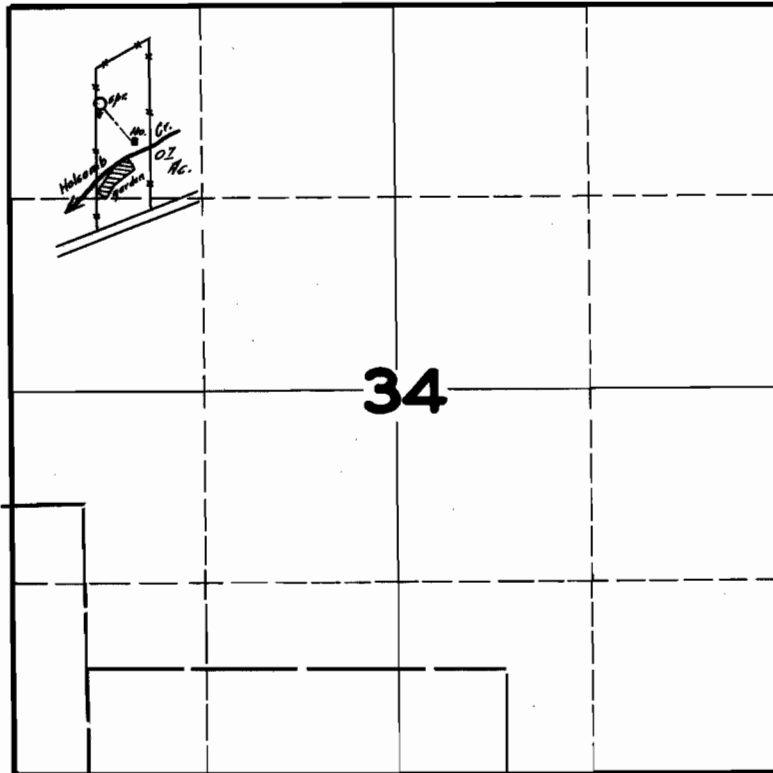

FINAL PROOF SURVEY UNDER

Application No. 19887 Permit No. 15473

IN NAME OF

PAUL SHIGLEY

Surveyed JUNE 15 1945, by [Signature]