


T. 2S. R. 3E. W. M.

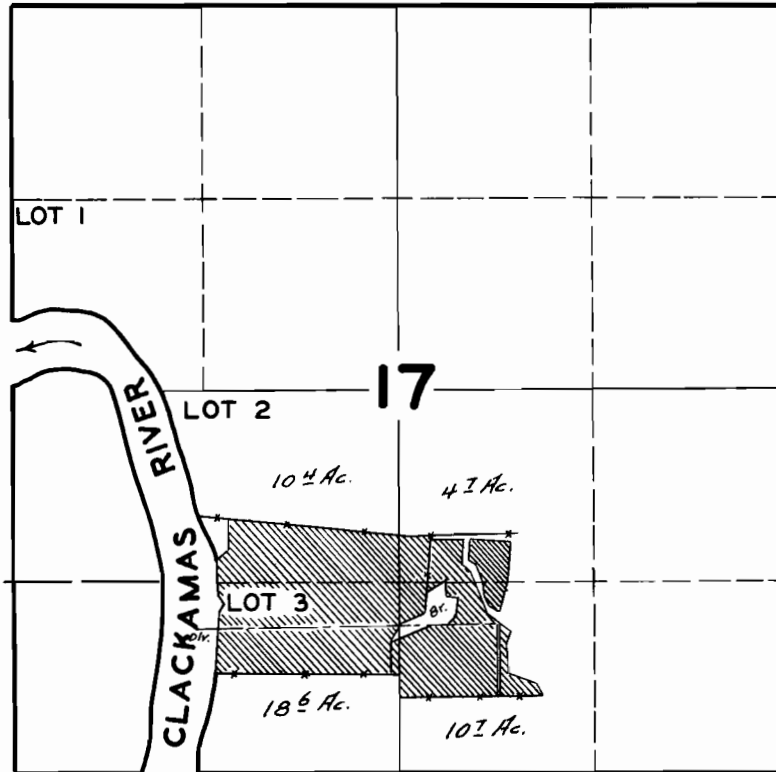

FINAL PROOF SURVEY UNDER

Application No. 20207 Permit No. 15758

IN NAME OF
WADE NEWBIGIN

Surveyed JUNE 20 1946, by