

Sec. 28

29


32

33

Tp. 36 S.

R. 5 W.

W. M.

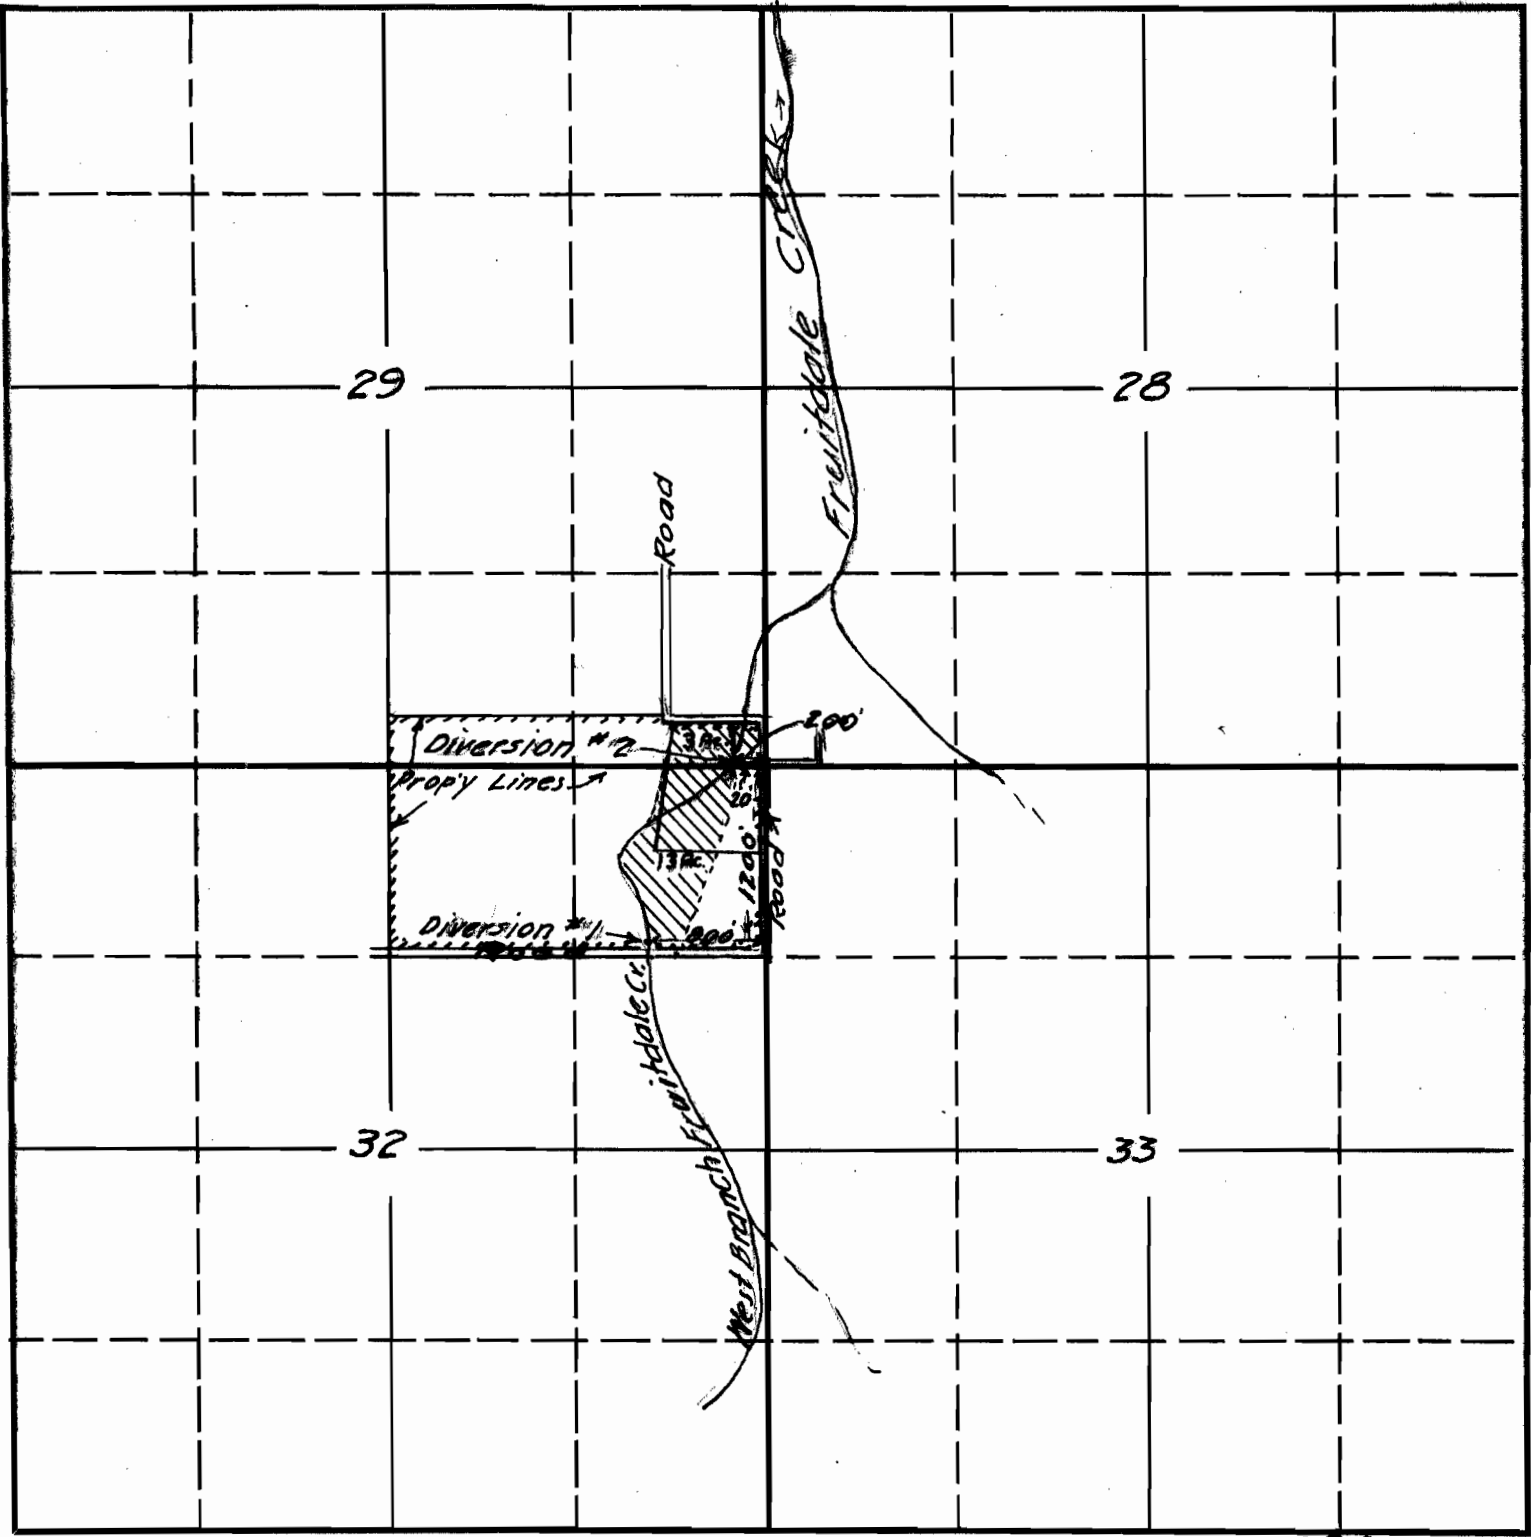

B.L. Huston
 July 1945

20994
 15-78C
 Application No. 20994.
 Permit No. 16433....

RECEIVED
 JUL 20 1945
 STATE ENGINEER
 SALEM, OREGON