

Sec.


31

32

Tp. 35 S.

R. 6 W.

N.M.

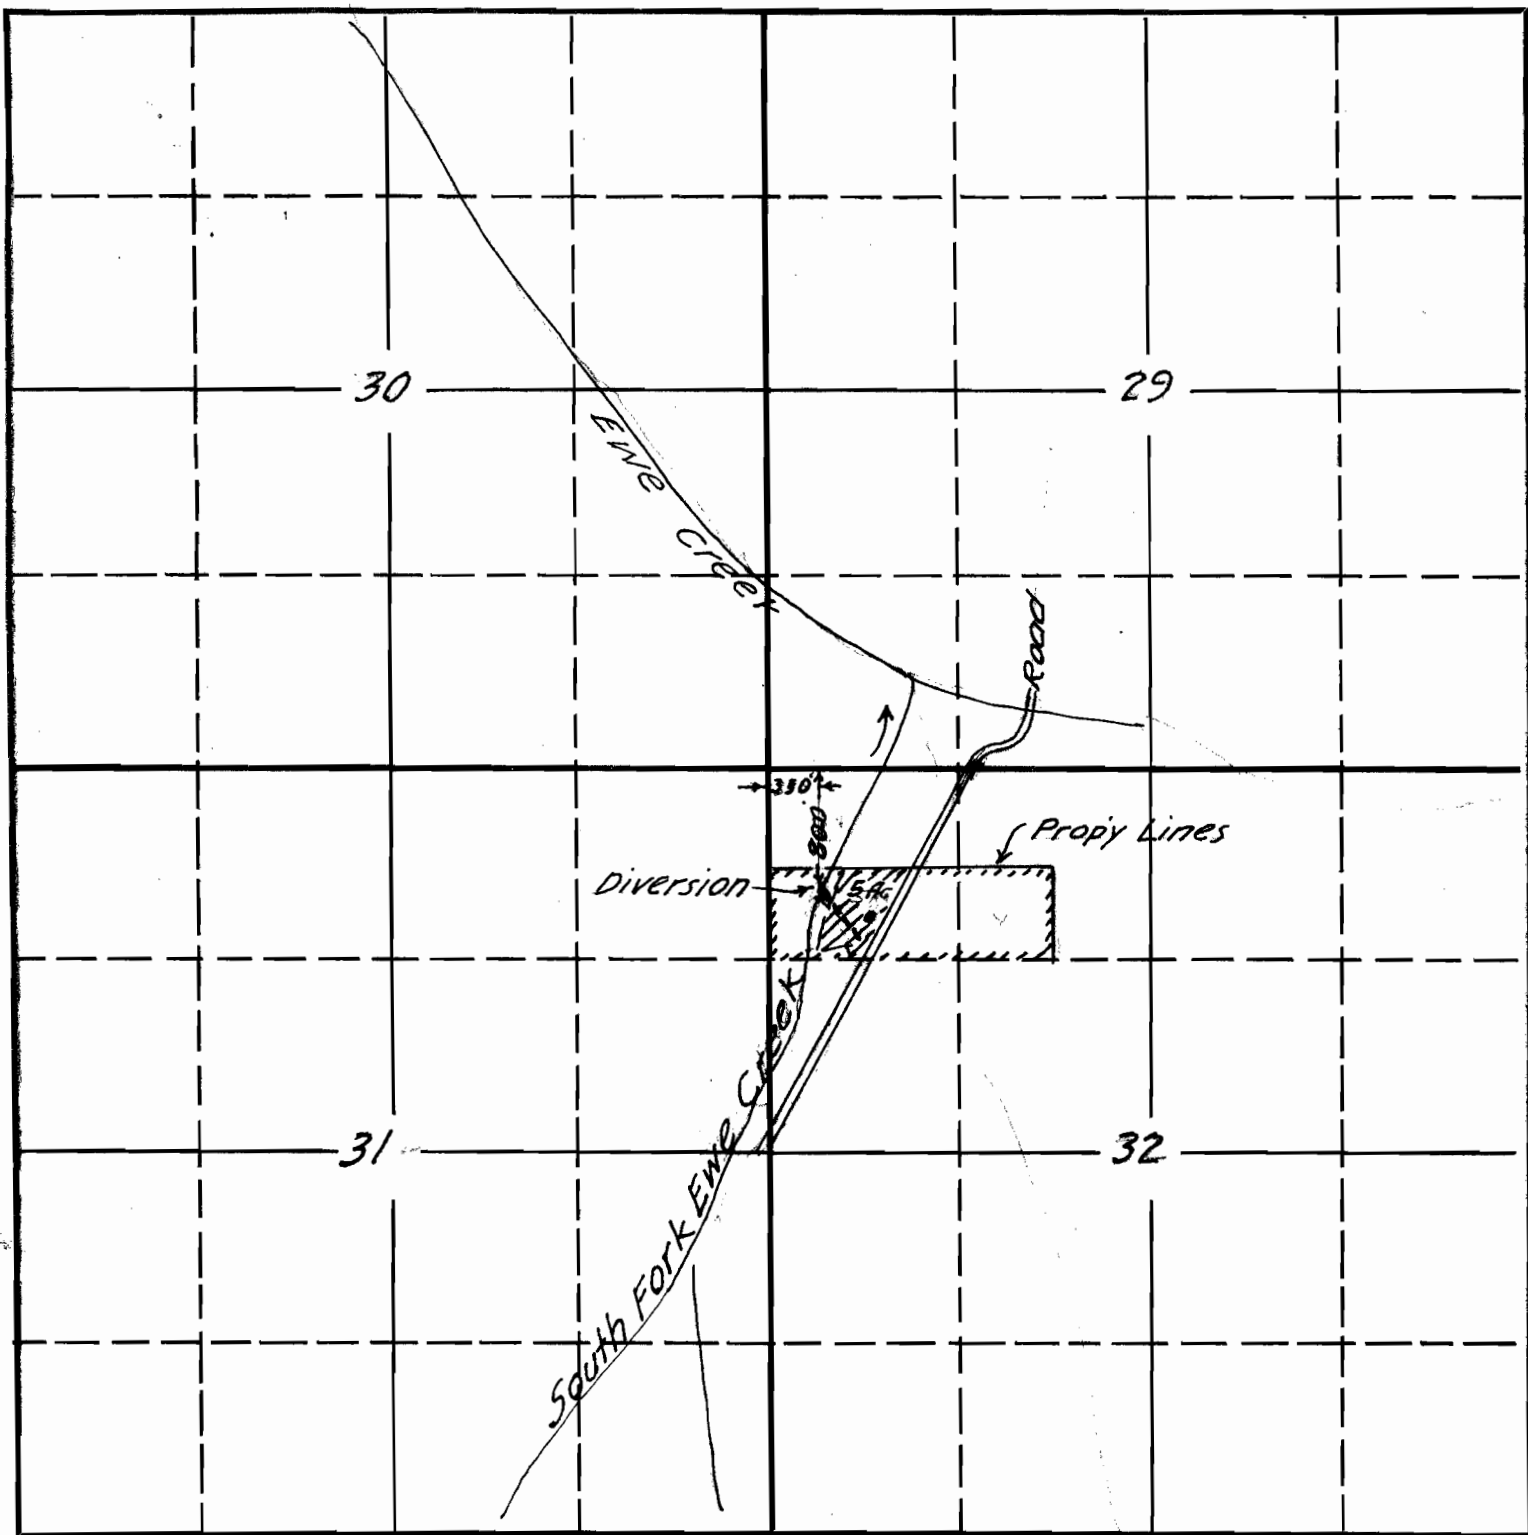

20995
15-78C

Charlotte T. West
July 1945

Application No 20995
Permit No...16434...

RECEIVED
JUL 20 1945
CIVIL ENGINEER
EUREKA, OREGON