

SECTION


34, 35

TOWNSHIP 30 S, RANGE 6 W, W. M.

North

34

35

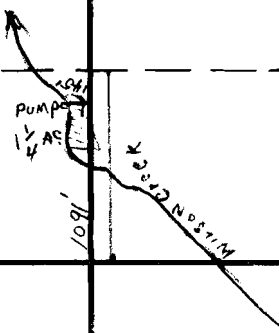

West

East

South

21405

16-12

RECEIVED

FEB 11 1946

STATE ENGINEER
SALEM, OREGON

APPLICATION No. 21405

PERMIT No. 16774