


T41S, R9W, W.M.

Scale 400' = 1"

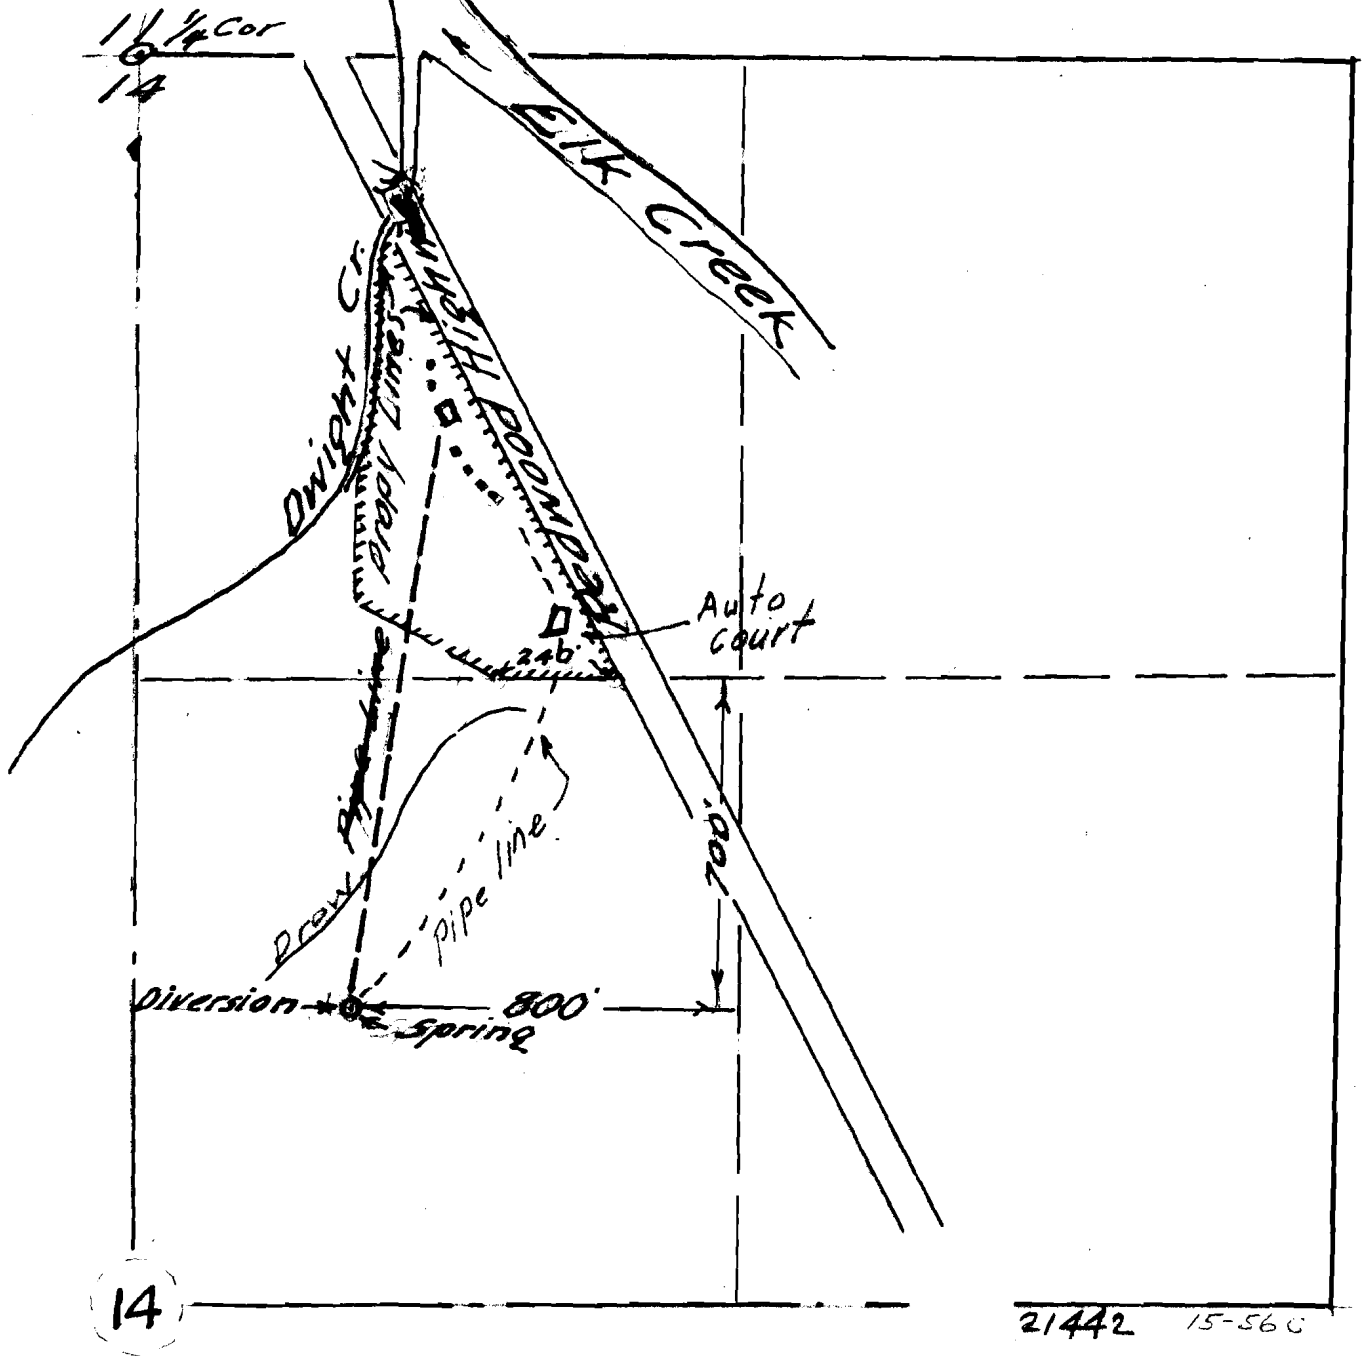

Stella K. Johnson
Feb. 1946

Application No 21442
Permit No. 16823

RECEIVED

FEB 15 1946

