


SECTION

16

TOWNSHIP 35 S, RANGE 7 W, W. M.

North

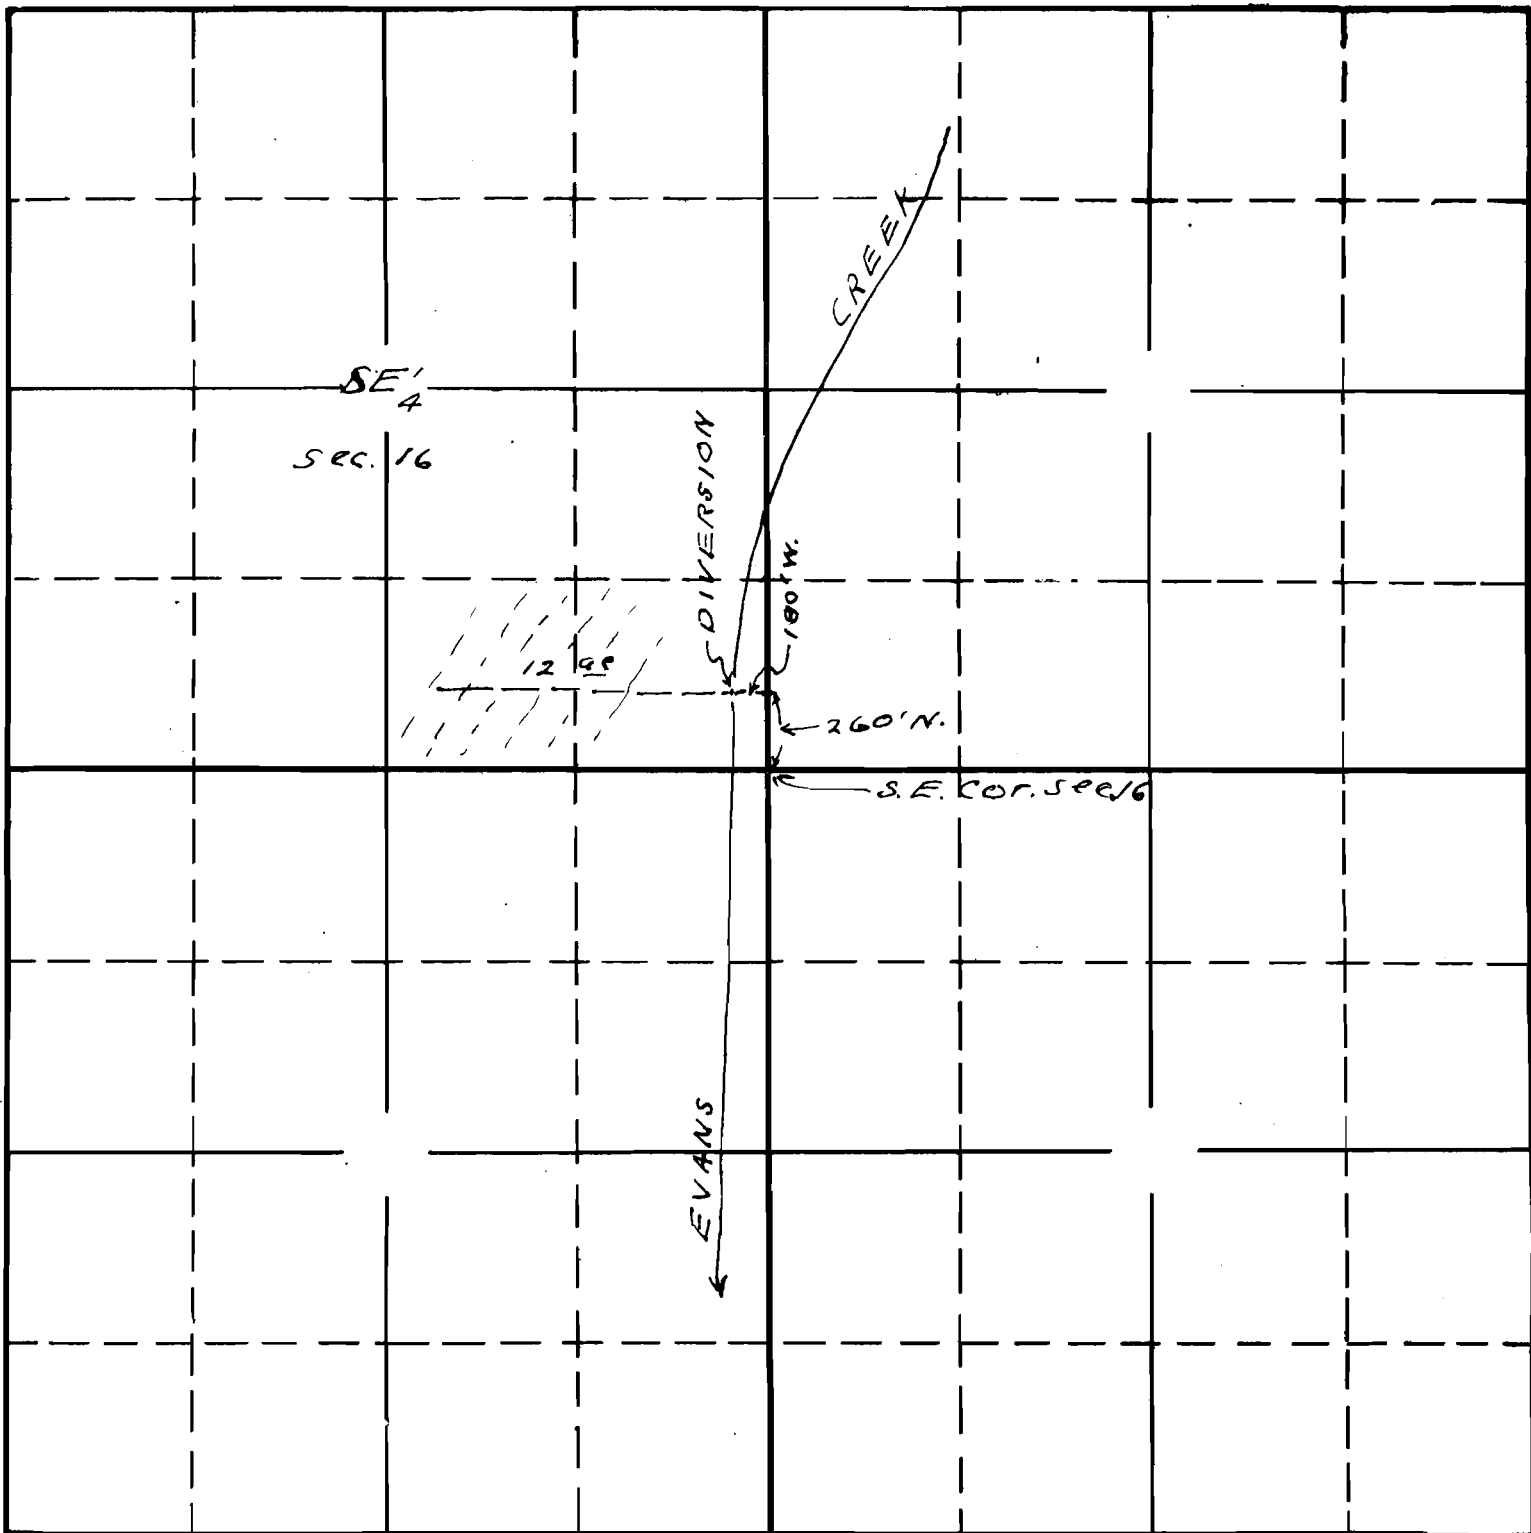

South

22246

15-97

Map To accompany application of A.V. Hornback for use of water from EVANS Creek for irrigation purposes.

APPLICATION No. 22246

PERMIT No. 17508

This office 2/11/47 *[Signature]*