


T. I. S. R. 35 E. W. M.

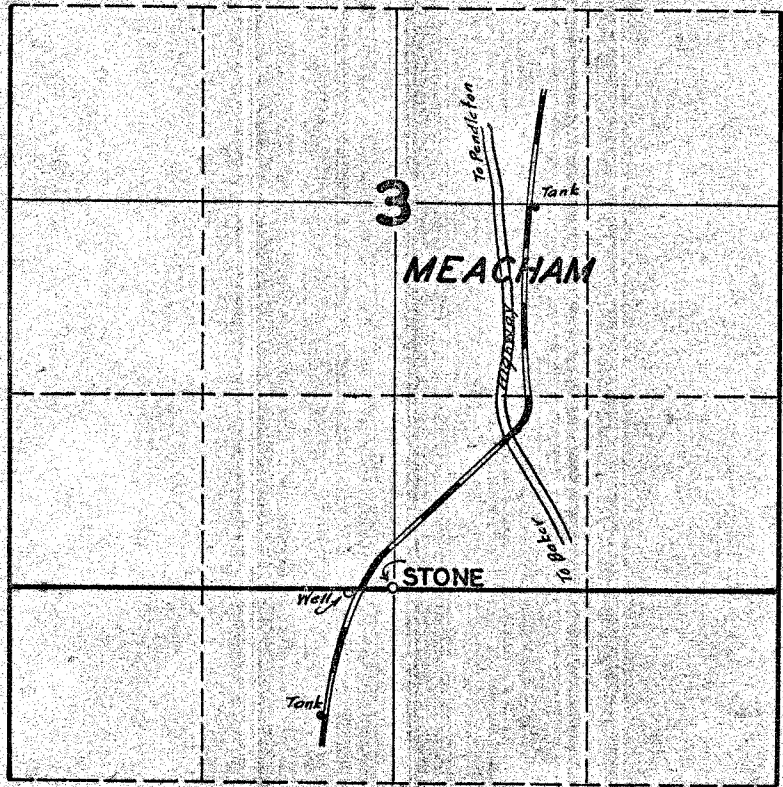

FINAL PROOF SURVEY UNDER

Application No. U-202 Permit No. U-183

IN NAME OF

ORE.-WASH. R.R. & NAV. CO. AND ITS LESSEE-UNION PAC. R.R. CO.

Surveyed APR. 24 1947, by JAS. E. BUNNELL