


**T.3S.R.40E.W.M.**

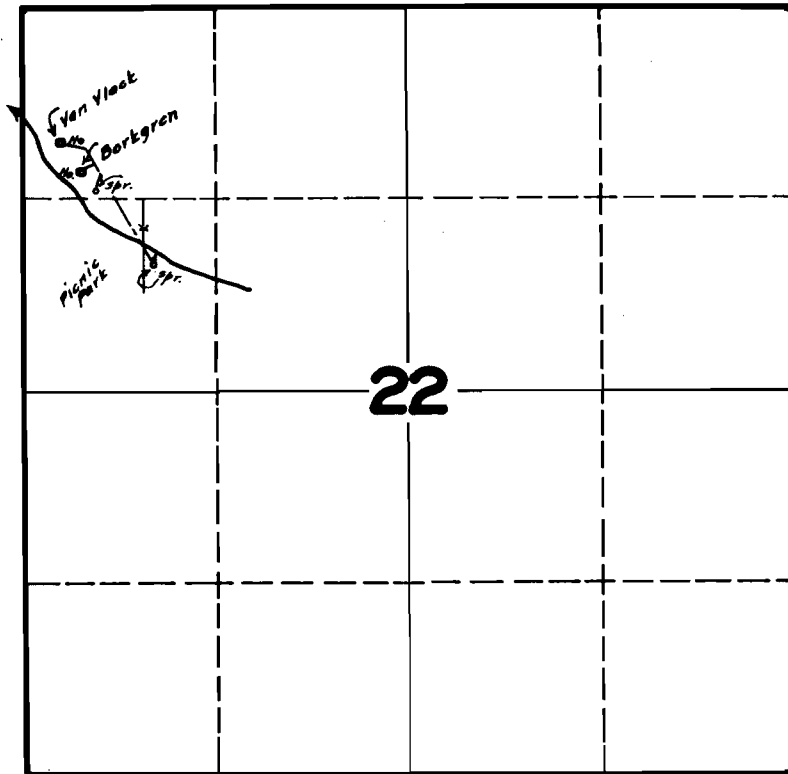

**FINAL PROOF SURVEY**  
UNDER

Application No. 21461 Permit No. 16920  
IN NAME OF

ED VAN VLACK & ROYAL BORKGREN

Surveyed MAY 13 1947, by JAS. E. BUNNELL