


T.22S.R.5W.W.M.

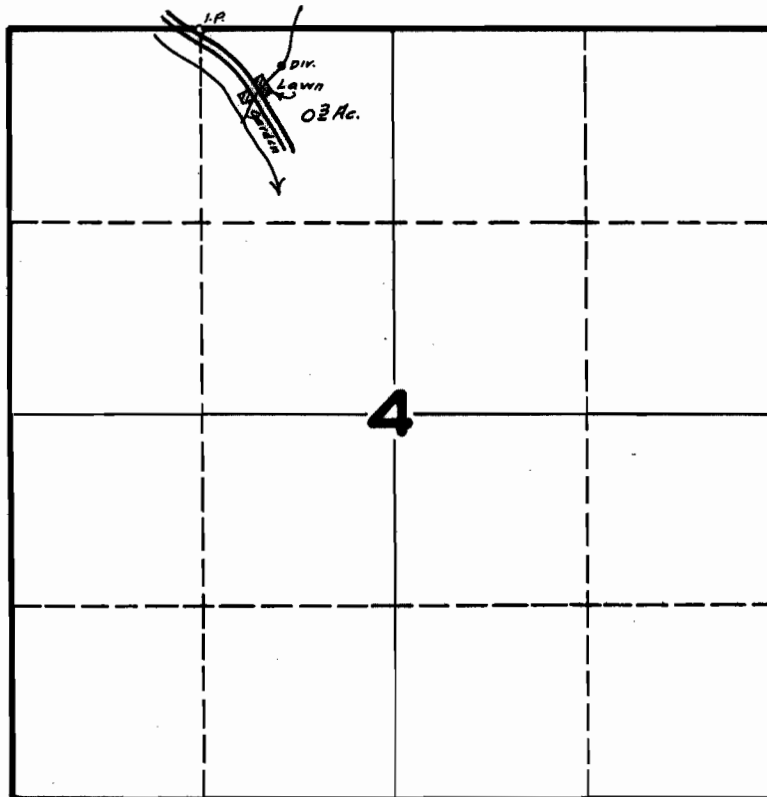

FINAL PROOF SURVEY
UNDER

Application No. 20998 Permit No. 16437

IN NAME OF

GRACE MOORMAN

Surveyed JUNE 6, 1947, by JAS. E. BUNNELL