


# T.14&15S.R.16E.W.M.

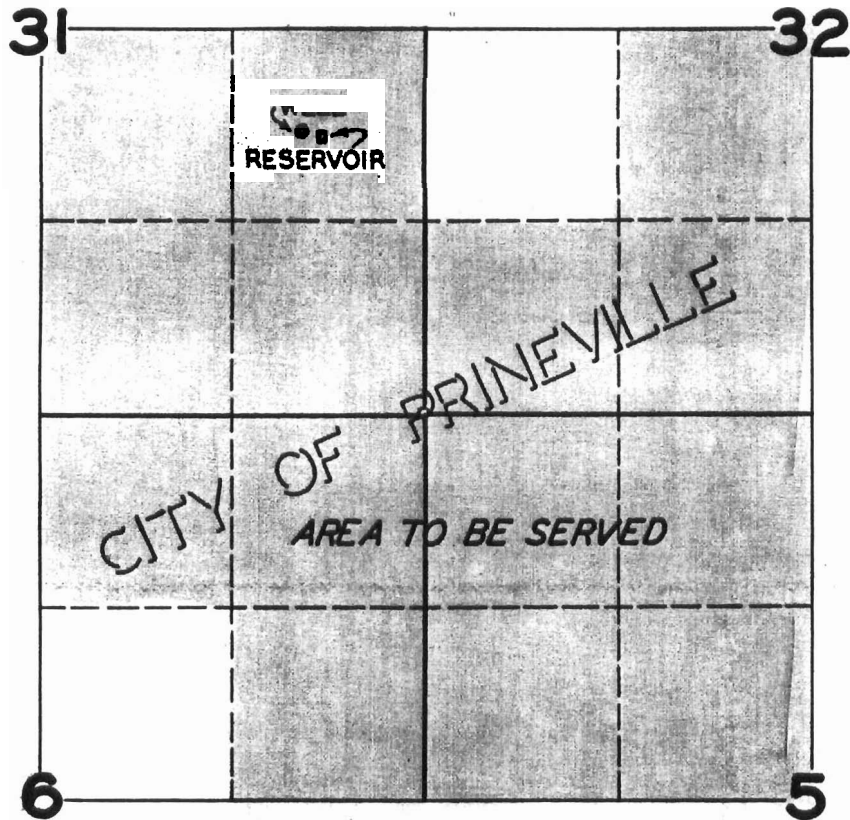

## FINAL PROOF SURVEY UNDER

Application No. U-140 Permit No. U-133

IN NAME OF  
CITY OF PRINEVILLE

Surveyed APR. 30 1946, by [Signature]