


# T.38S.R.9E.W.M.

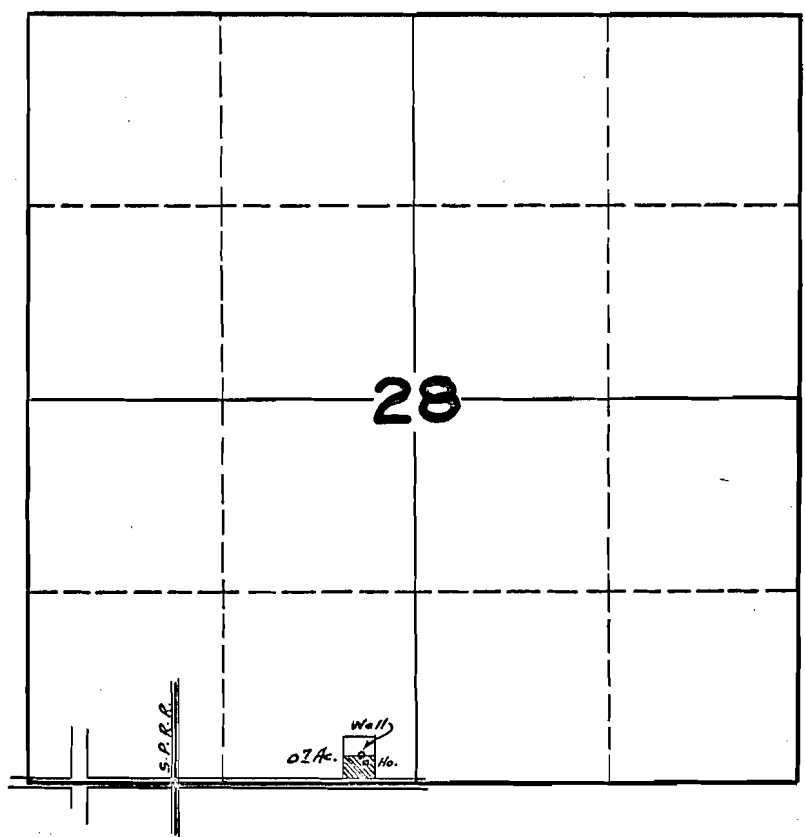

## FINAL PROOF SURVEY UNDER

Application No. U-145 Permit No. U-137

IN NAME OF  
**A. A. SOULE**

Surveyed MAY 20 1946, by *[Signature]*