


T.15S.R.43E.W.M.

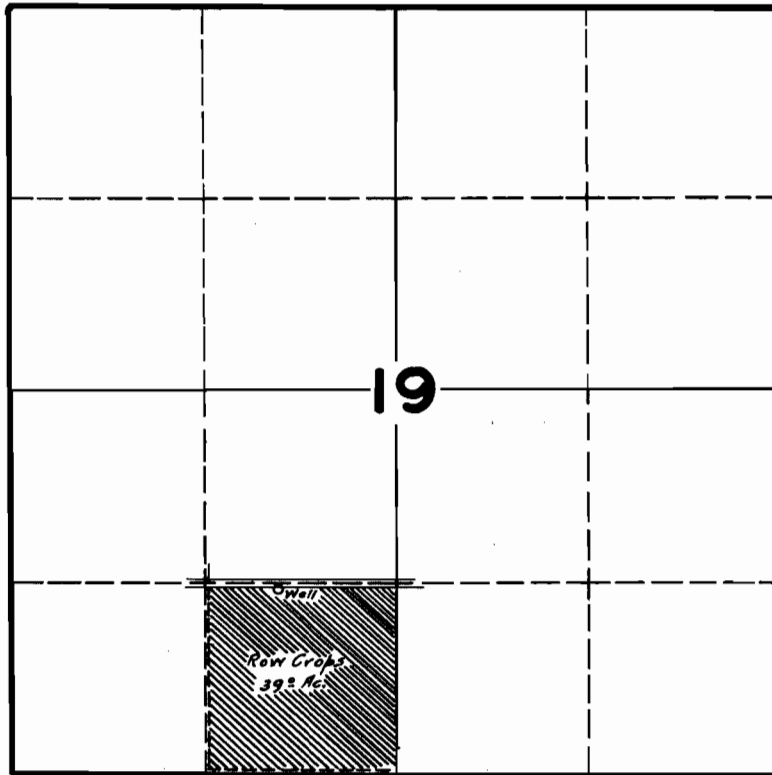

**FINAL PROOF SURVEY**  
UNDER

Application No. U-124 Permit No. U-118

IN NAME OF

FREDERICK T. ARNOLD

Surveyed MAY 31 1946, by

Handwritten signature of the surveyor, likely a name like 'Russell'.