


U-121

T.2N.R.12E.W.11.

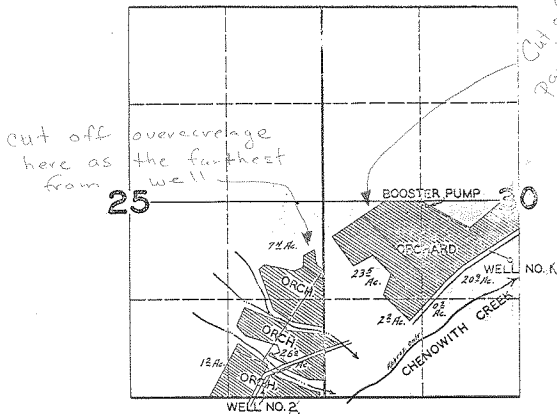

FINAL PROOF SURVEY
UNDER

Application No. U-127... Permit No. U-121

IN NAME OF

WARD R. WEBBER

Surveyed APR. 11, 1946, by JAS. E. BUNNELL

Application No. U-219
Permit No. U-385