


T. IN. R. 13E. W. M.

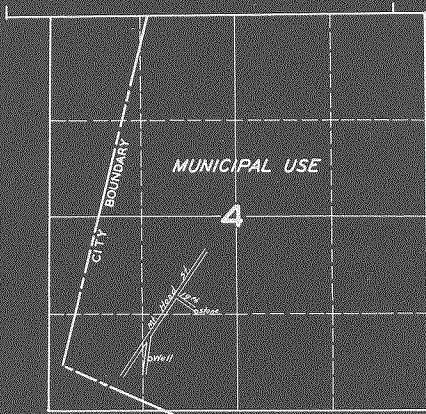

FINAL PROOF SURVEY  
UNDER

Application No. U-135 Permit No. U-127  
IN NAME OF

THE DALLES WATER COMMISSION

Surveyed APR. 10, 1946, by JAS. E. BUNNELL