


# T. 14S. R. 15E. W. M.

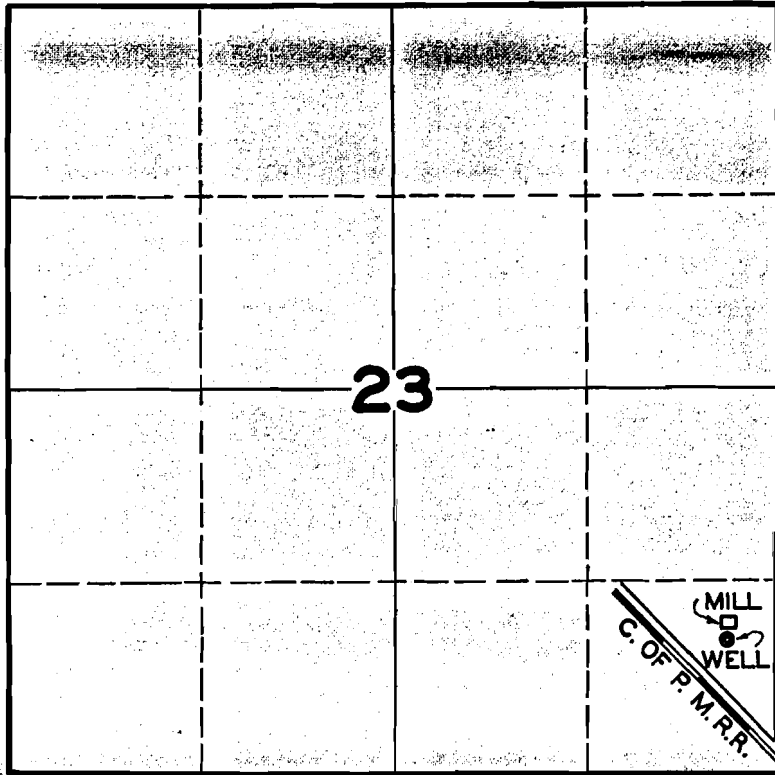

## FINAL PROOF SURVEY UNDER

Application No. U-142 Permit No. U-135

IN NAME OF  
PINE PRODUCTS CORP.

Surveyed APR. 30 1946 by [Signature]

U-135  
1946-B

2-135